


MICROFILMED

FILED
GREENVILLE CO. S. C.

OCT 19 4 26 PM '79

DONNIE S. TANKERSLEY
R.M.C.

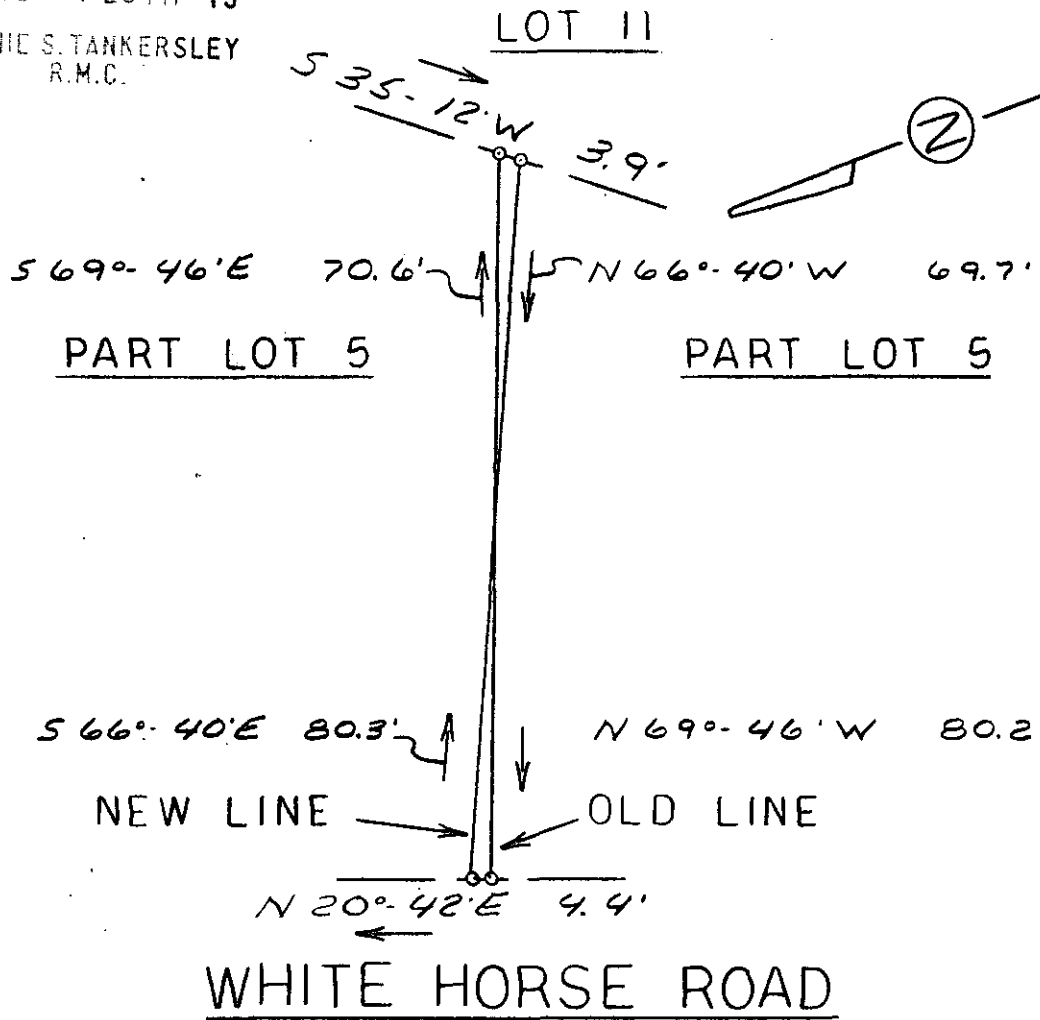

6 OCT 1979 1 06 19 79 1336

OCT 19 1979

13285

✓ 7-R-79

B 6-1-46



STATE OF SOUTH CAROLINA
GREENVILLE COUNTY

SURVEY FOR
JERRY W. LEE

FREELAND & ASSOCIATES
Engineers • Land Surveyors

GREENVILLE, S.C.

SURVEY	F.E.L.
DRAWN	M.C.
CHECK	M.C.
SCALE	1" = 40'
DATE	10-12-79
DWG. NO.	79-4207-B