MICROFILMED

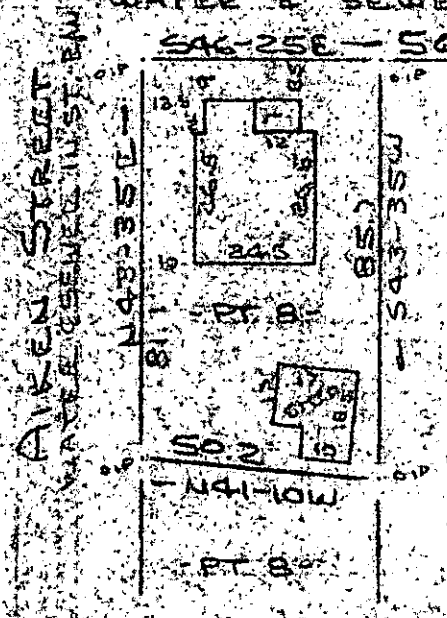

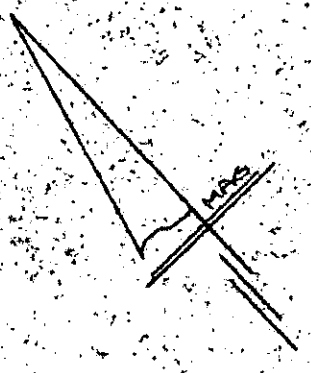

Note: Improvements on this lot are not in a flood hazard area.

FILED
GREENVILLE CO. S.C.
NOV 21 4 14 PM '79
DONNIE S. TANKERSLEY
R.M.C.

PROPERTY OF
SYLVESTER PALMER
GREENVILLE S.C.
SCALE: 1"=40' 19 NOV 1979

This is to certify that on the 19th day of November, 1979, I surveyed the property shown on this plat, being known as part of lot 8 on plat of BLOCK " C " MELVILLE LAND CO. PROPERTY and recorded in the RMC Office Greenville County, S. C., in Plat Book " A " at Page 97; and that the property lines, walls and buildings are as shown hereon, and that the walls and buildings located on said lot do not encroach or project on adjacent street or property, and that no adjacent walls or buildings encroach or project on said premises, and no power lines cross this property except as shown hereon. Also known as PROPERTY OF SYLVESTER PALMER and recorded in Plat Book at Page .

R. B. Bruce

R. B. Bruce, RLS #1952

7-S-31

CAROLINA SURVEYING CO.
112 Manly St.
Greenville, S. C.

17280

NOV 21 1979

5 9 8 NW 21 E

300 A4