


MICROFILMED

FILED  
GREENVILLE CO. S. C.

DEC 26 2 46 PM '79

DONNIE S. TANKERSLEY

B.M.C.  
22

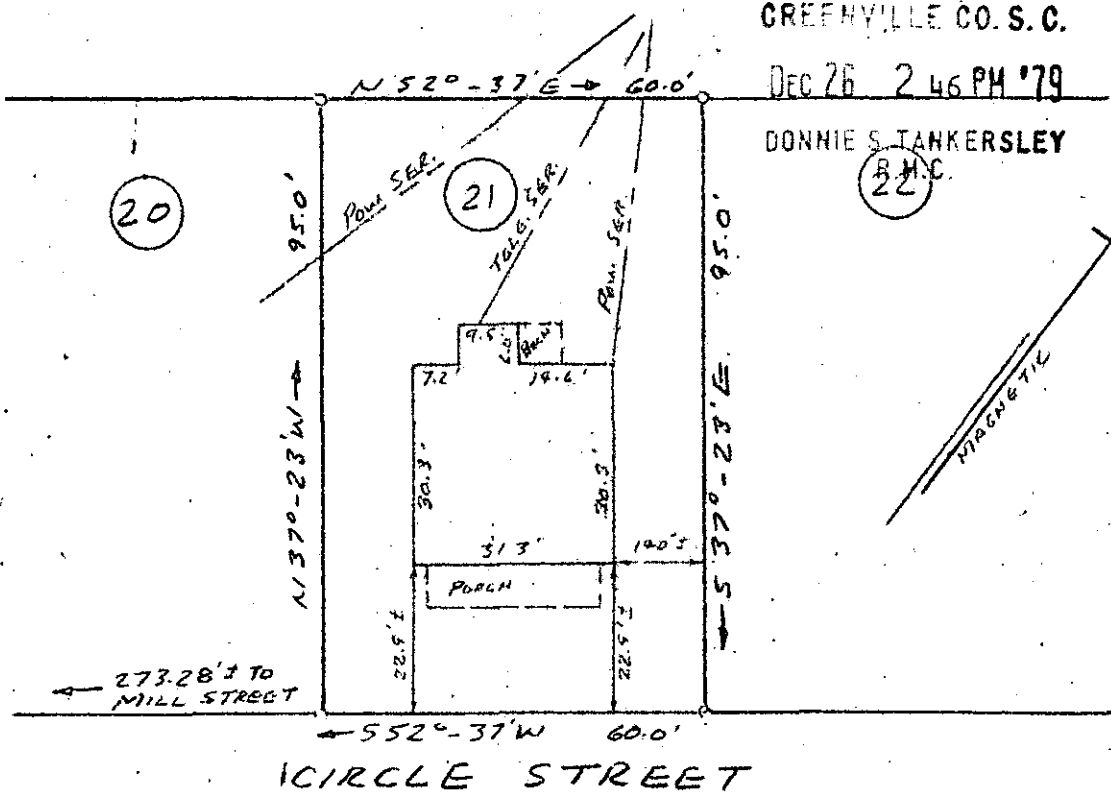

PROPERTY OF  
TERRY L. PHILLIPS &  
DORA B. PHILLIPS  
 TAYLORS, GREENVILLE CO., SOUTH CAR.  
 DEC. 17, 1979 SCALE: 1" = 30'


This is to certify that on December 17, 1979, I surveyed the property shown on this plat, known as Lot No. 21 of Section No. 1 of Chick Springs as shown on a plat recorded in the RMG Office for Greenville County, in Plat Book PPP, Page 17, and that the property lines, walls and buildings are as shown hereon, and that the building located on said lot does not project nor encroach on adjacent streets or property, and that no adjacent walls or buildings project nor encroach on said lot, and that no utility lines cross this lot except as may be shown hereon.

NOTE: This property is not located within a flood hazard area.

Survey by: Richard R. Wooten, Jr.  
 Greenville, South Carolina

An easement is reserved for maintenance of all existing service and sewer lines crossing lots.

20444

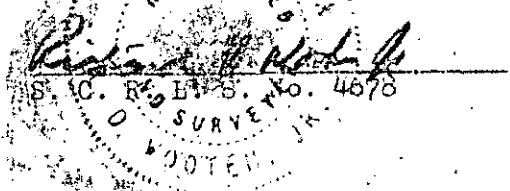

7-T-21

DEC 26 1979

GCTO -----2 DE26 79 1339

3.00CI