


MICROFILMED

FILED
GREENVILLE CO. S.C.
DEC 28 3 11 PM '79
DONNIE S. TANKERSLEY
R.M.C.
64

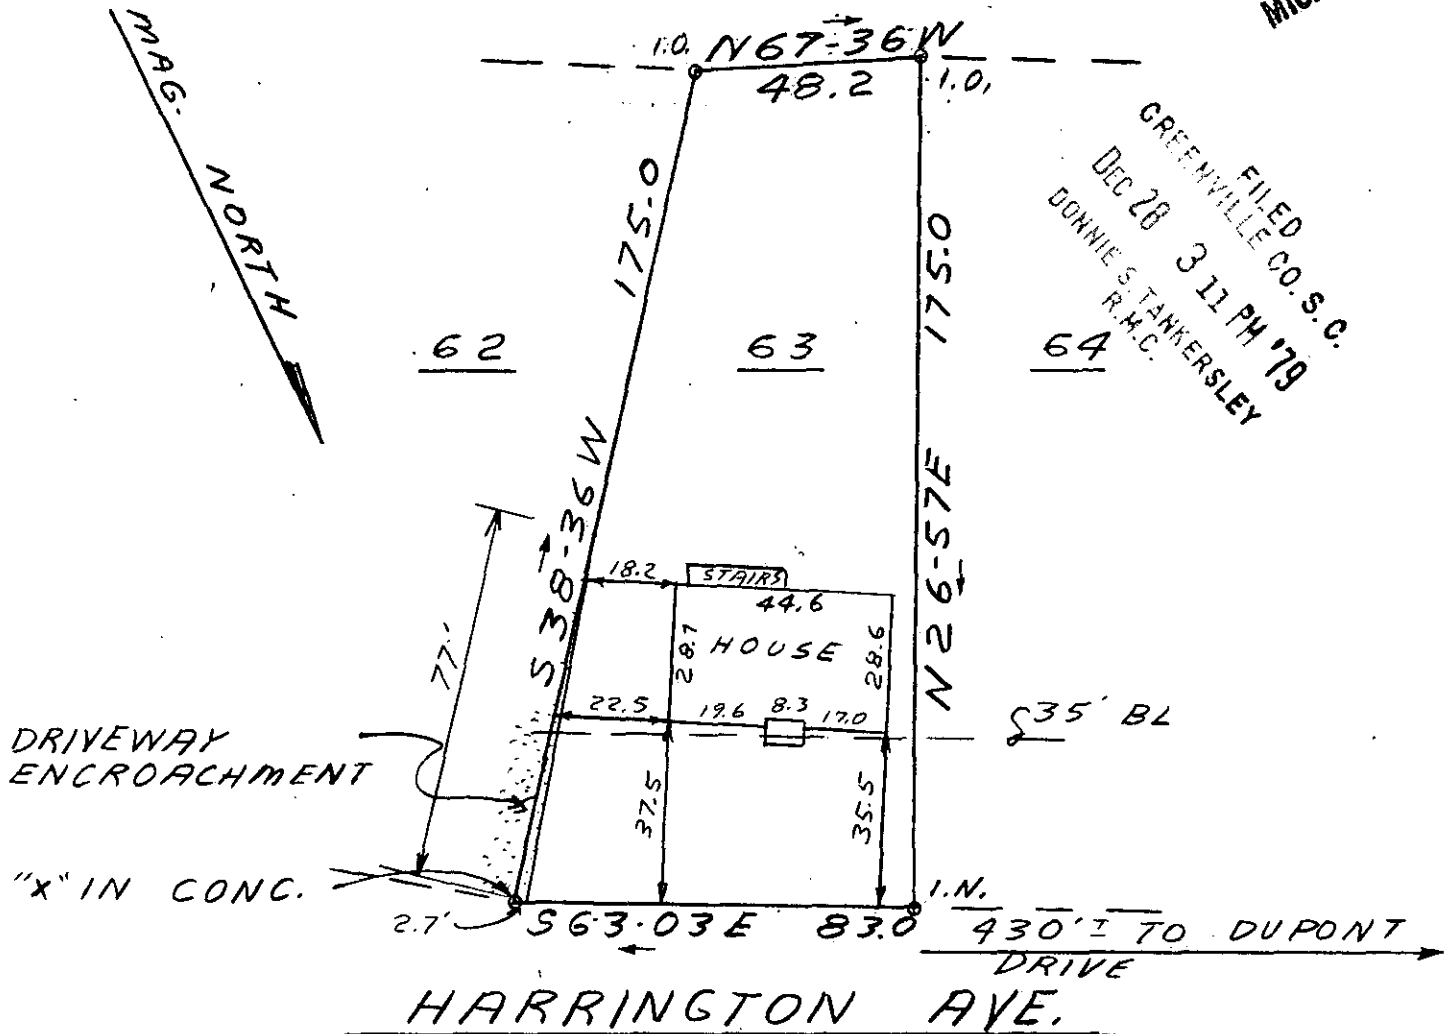

This is to certify that on December 26, 1979, I surveyed the property shown on this plat, known as Lot 63 on plat of Isaqueena Park, recorded in the RMC Office of Greenville County in Plat Book P on page 130, and that the property lines, walls and buildings are as shown hereon; that the building located on said lot does not encroach or project on adjacent streets or property, and that no adjacent walls or buildings encroach or project on said premises, and that no utility lines cross this property except as shown hereon. This property is not located in a designated flood hazard area.

DEC 28 1979 20698

9-T-33 James R. Freeland
James R. Freeland RLS & PE 4781

189.3-7-17



SEAL

STATE OF SOUTH CAROLINA
GREENVILLE COUNTY

ISAQUEENA PARK
LOT 63
PROPERTY OF
GEORGE MICHAEL BRELAND

FREELAND & ASSOCIATES
Engineers • Land Surveyors

GREENVILLE, S.C.

SURVEY LT
DRAWN JRF
CHECK MC
SCALE 1" = 40'
DATE 12-26-79
DWG. NO. 79-4573