

FILED
GREENVILLE CO. S. C.

JAN 3 12 03 PM '80

DONNIE S. TANKERSLEY
R.M.C.


MICROFILMED

Note:
Improvements on this
lot are not in a
flood hazard area.

THE POINSETT CLUB

STREET
IN ST. R/W

PEYTON
SEWER
WATER

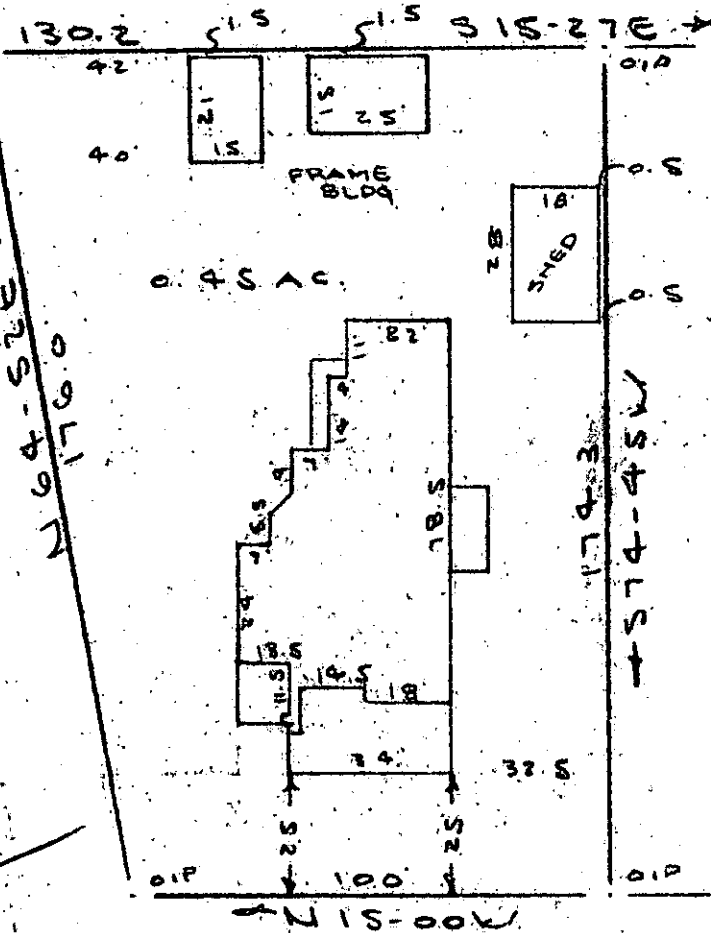

WESTENBURG

7.T.44

21087

MANLY STREET
WATER & SEWER IN ST. R/W

PROPERTY OF
THE POINSETT CLUB
GREENVILLE, S.C.
SCALE: 1" = 40' 31 DEC 1979

This is to certify that on the 31st day of December, 1979, I surveyed the property shown on this plat, being known as PROPERTY OF THE POINSETT CLUB and recorded in the RMC Office Greenville County, S. C., in Plat Book _____ at Page _____; and that the property lines, walls and buildings are as shown hereon, and that the walls and buildings located on said lot do not encroach or project on adjacent street or property, and that no adjacent walls or buildings encroach or project on said premises, and no power lines cross this property except as shown hereon.

[Handwritten Signature]

[Handwritten Signature]

R. B. Bruce, R.M.C.

GREENVILLE S.C. 29601
112 Manly St., Greenville, S. C.