

77-15
234339


JAN 30 1980

FILED
GREENVILLE CO. S. C.
JAN 30 10 40 AM '80
DONNIE STANKERSLEY
R.M.C.

This is to certify that on January 21, 1980, I surveyed the property shown on this plat, known as Lot 14 on plat of Lockwood Heights Sec. 2, recorded in the RMC Office of Greenville County in Plat Book RR on page 11, and that the property lines, walls and buildings are as shown hereon; that the building located on said lot does not encroach or project on adjacent streets or property, and that no adjacent walls or buildings encroach or project on said premises, and that no utility lines cross this property except as shown hereon. This property is not located in a designated flood hazard area.

James R. Freeland
James R. Freeland R/S & PE 4781

2322-1-14

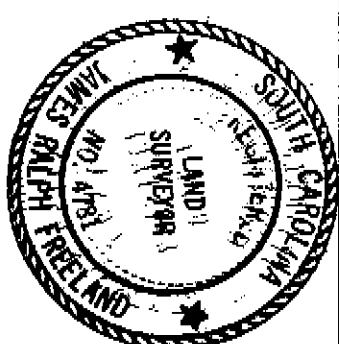

STATE OF SOUTH CAROLINA
GREENVILLE COUNTY

LOCKWOOD HEIGHTS

SEC. 2 - LOT 14

PROPERTY OF

JOE THOMAS LLOYD

BETTY J. LLOYD

FREELAND & ASSOCIATES
Engineers • Land Surveyors
GREENVILLE, S.C.

SURVEY *Y/B*
DRAWN *M.C.*
CHECK *M.C.*
SCALE *1" = 40'*
DATE *1-21-80*
DWG. NO. *80-4656*

MICROFILMED