
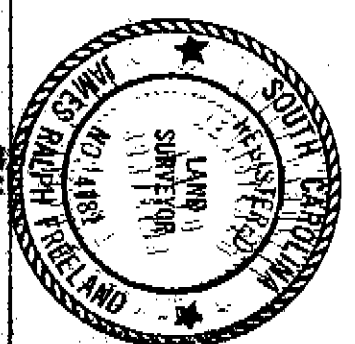


FILED
GREENVILLE CO. S. C.
FEB 1 3 30 PM '80
DONNIE S. TANKERSLEY
R.M.C.

23692
7-11-16
FEB 1 1980

This is to certify that on January 30, 1980, I surveyed the property shown on this plat, known as Property of Bruce MacLain and Shirley K. Strickland, recorded in the REC Office of Greenville County in Deed Book 893 on page 215, and that the property lines, walls and buildings are as shown hereon; that the building located on said lot does not encroach or project on adjacent streets or property, and that no adjacent walls or buildings encroach or project on said premises, and that no utility lines cross this property except as shown hereon. This property is not located in a designated flood hazard area.

[Handwritten signature]
JAMES R. FREELAND

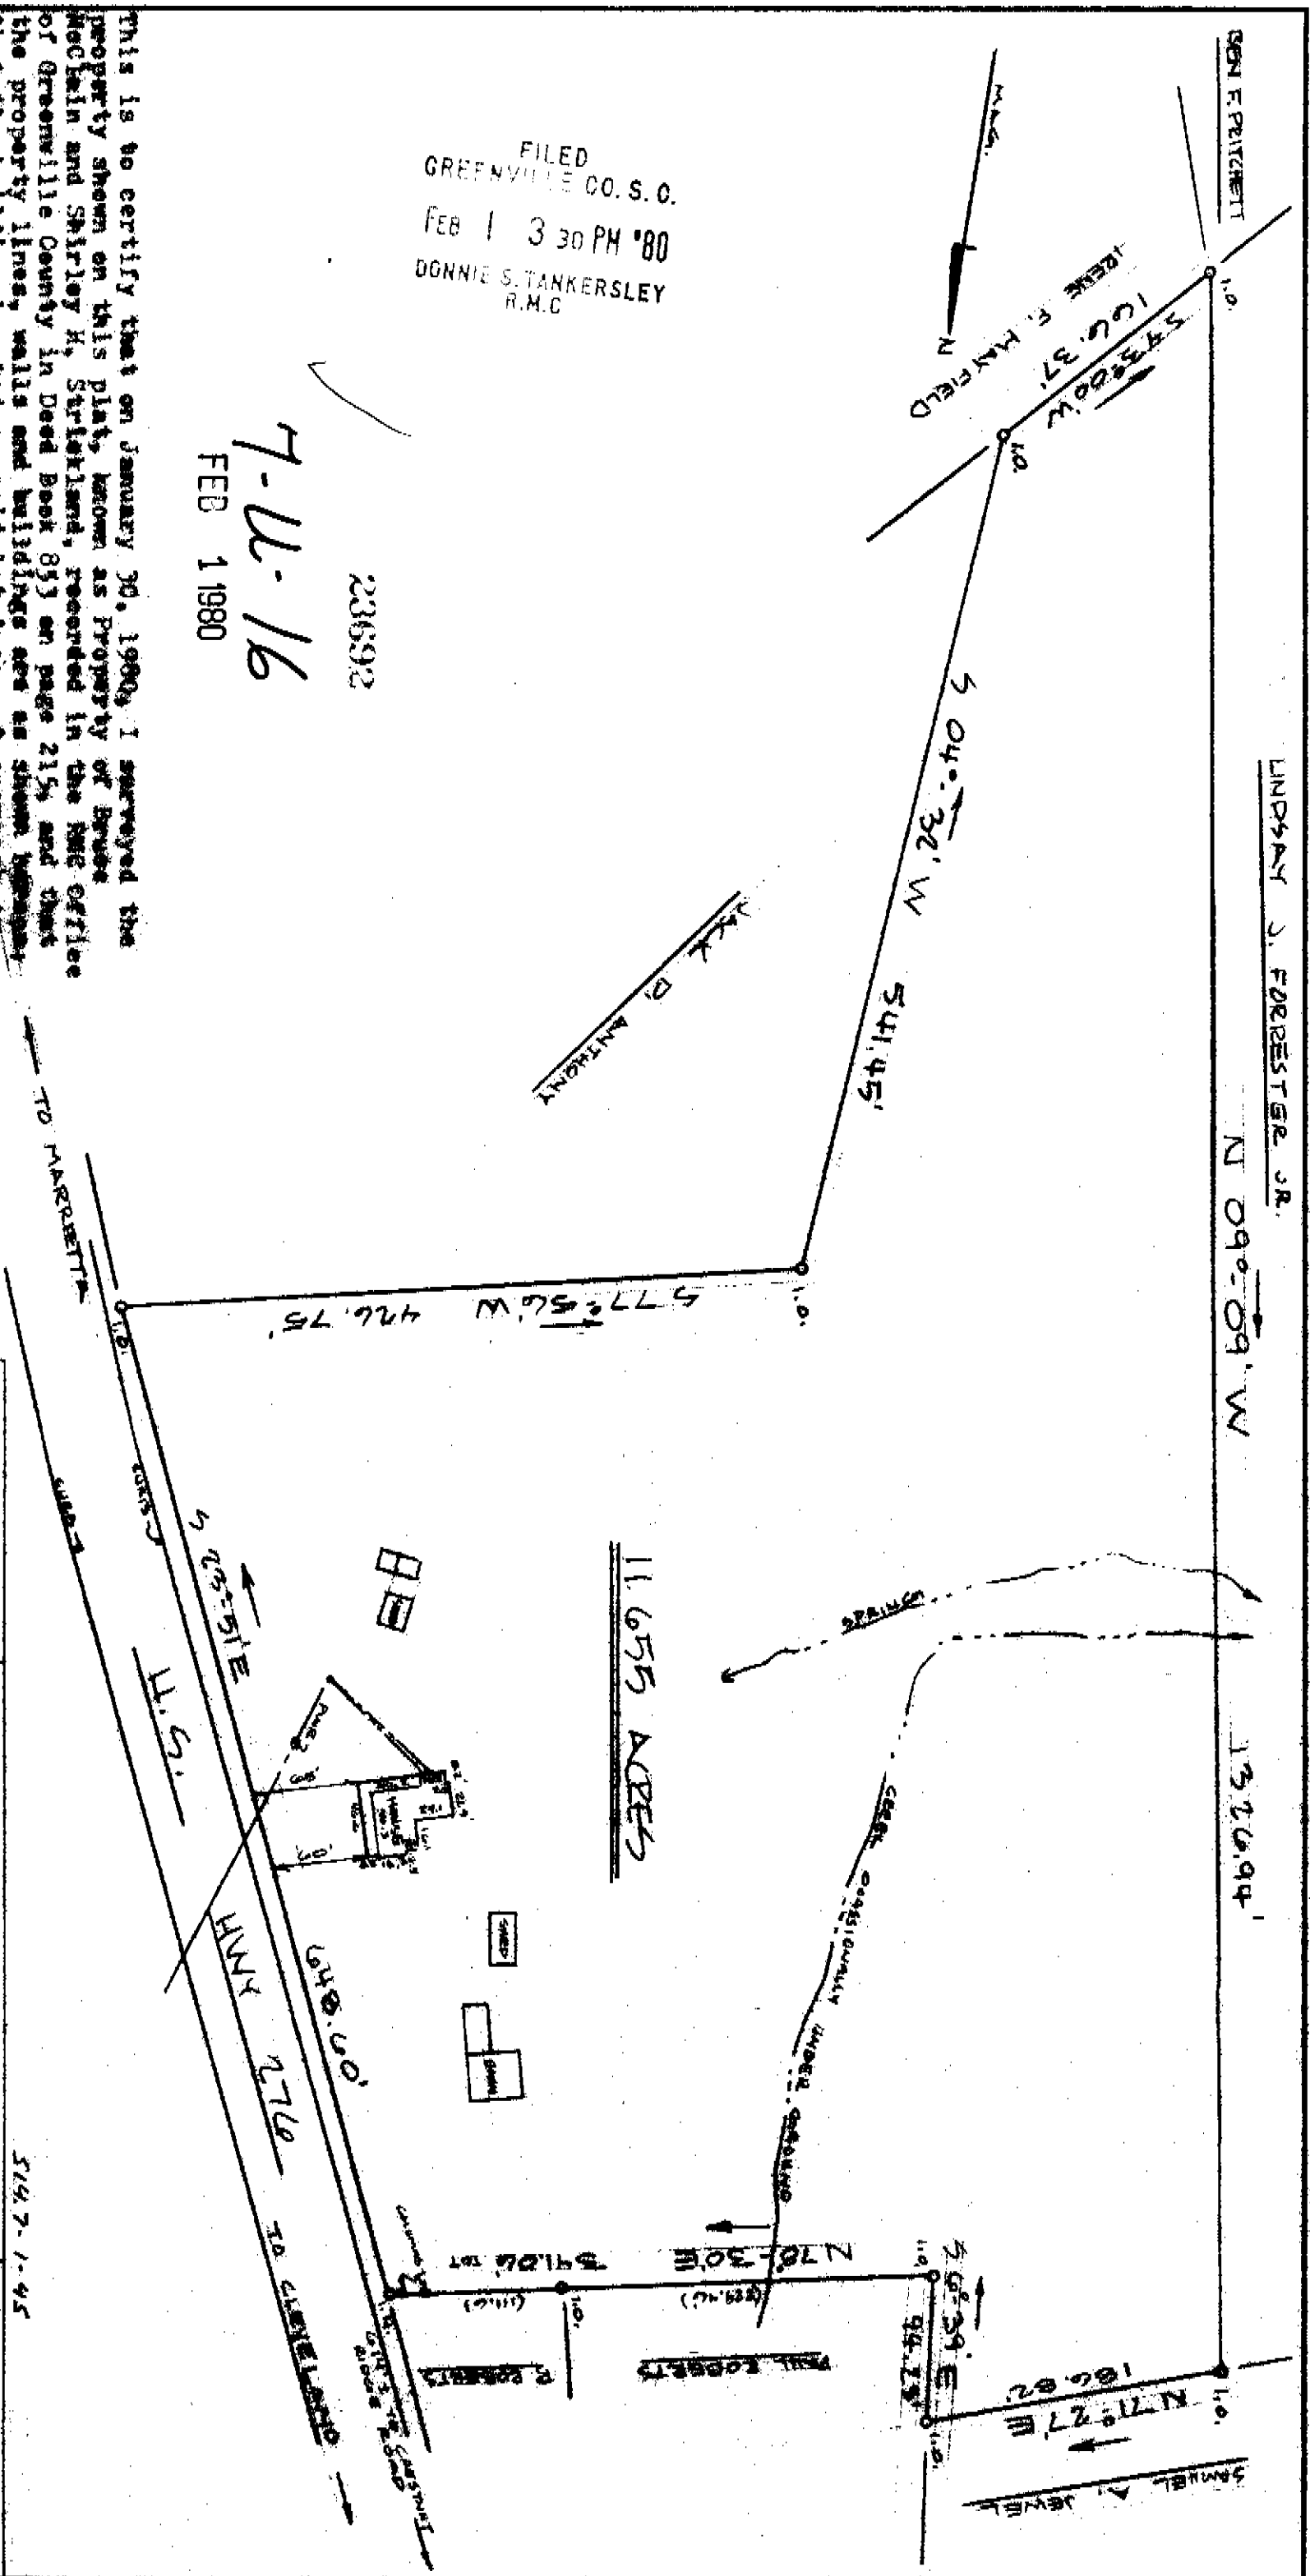

STATE OF SOUTH CAROLINA
GREENVILLE COUNTY

PROPERTY OF

ALEX R. GREGOR
NORMA E. GREGOR

FREELAND & ASSOCIATES
Engineers & Land Surveyors
GREENVILLE, S.C.

SURVEY	PL
DRAWN	PL
CHECK	ML
SCALE	1"=100'
DATE	1/30/80
BOOK NO.	80-4701