


PT	NE	BRG	LENGTH
54	34	6	25.8
55	32	34	7.801
58	57	24	117.635
64	32	54	144.806
62	34	34	123.360
54	56	35	144.612

MICROFILMED

FILED  
 GREENVILLE CO. S. C.  
 APR 1 2 30 PM '80  
 GEORGE B. TAMMERSLEY  
 R.M.S.

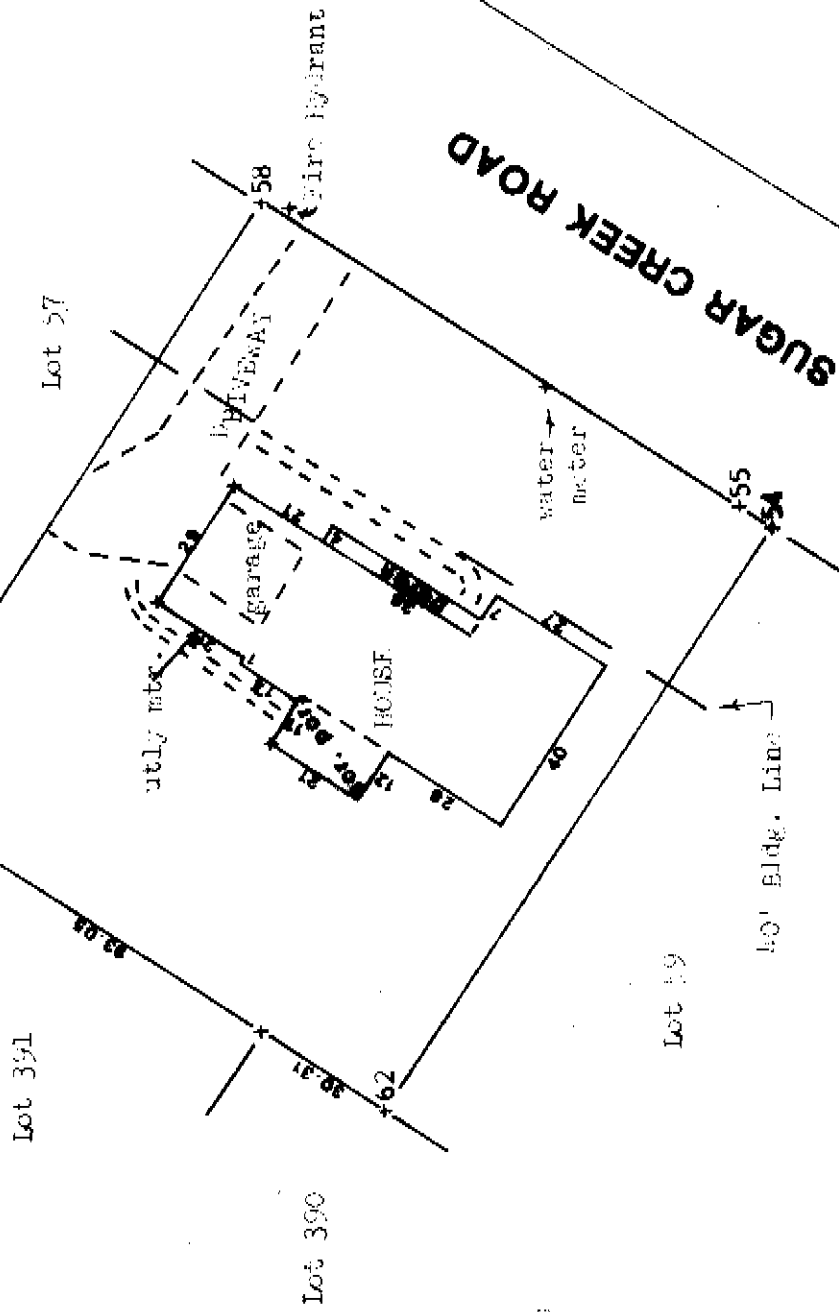

-NOTES-

All corners are existing Iron Pins

29119

APR 1 1980

7-4-59



I certify that I surveyed this property and found that there are no encroachments on this property and that this property does not encroach on adjoining property. This property is not located in a flood hazard area.

*John R. Long*  
 S.C. R.L.S. 6270

APR 1 1980

William H., Jr. & Rebecca B. Ferguson

SCALE: 1"=40'

DATE: 03-26-80

APPROVED BY

DRAWN BY

Property being Lot 58, Section II SUGAR CREEK, GREENVILLE CO.,  
 Ref: Deed Book 973, Pg. 158, Plat Book P-7-C, P. 66

105 Sugar Creek Road, Greenville, S.C. 29615  
 0.111 Acres  
 DRAWING NUMBER