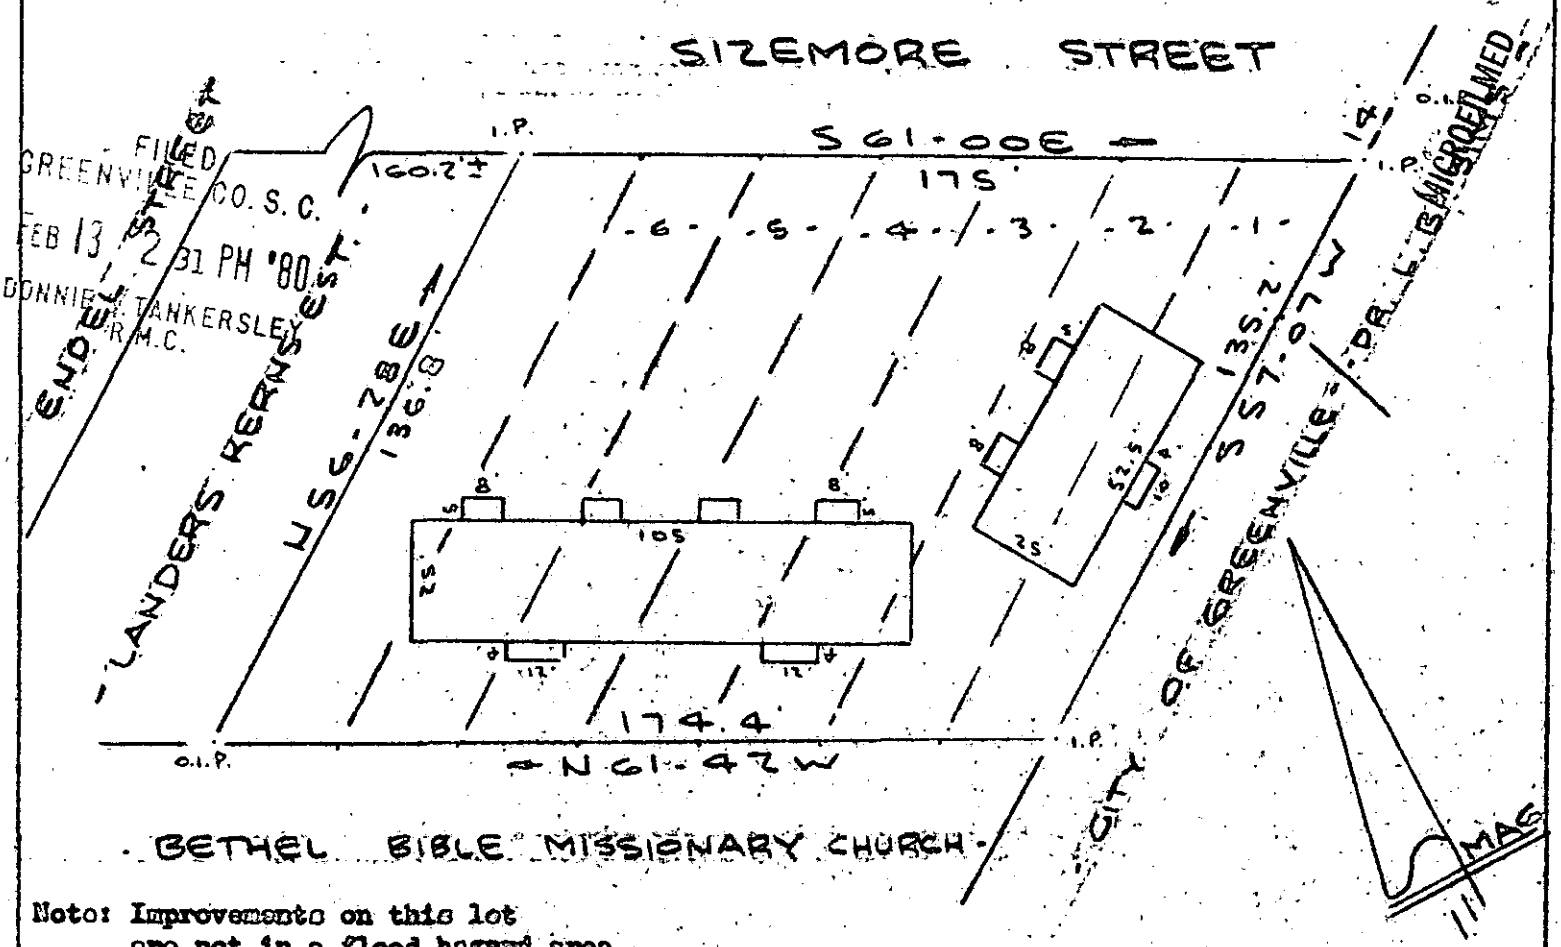

FILED
GREENVILLE CO. S.C.
FEB 13 2 31 PM '80
DONNIE S. TANKERSLEY
R.M.C.

Note: Improvements on this lot
are not in a flood hazard area.

PROPERTY OF
STEVE P. LOFTIS AS TRUSTEE
GREENVILLE, SOUTH CAROLINA
SCALE 1:40 12FEB1980

This is to certify that on the 12th day of February, 1980, I surveyed the property shown on this plat, being known as lots 1 through 6 on plat of PROPERTY OF STEVE P. LOFTIS AS TRUSTEE and recorded in the RMC Office Greenville County, S. C., in Plat Book at Page ; and that the property lines, walls and buildings are as shown hereon, and that the walls and buildings located on said lot do not encroach or project on adjacent street or property, and that no adjacent walls or buildings encroach or project on said premises, and no power lines cross this property except as shown hereon.

R. B. Bruce
R. B. Bruce, RLS #1952

7-V-29

24605

FEB 13 1980

See deed 1119-916

CAROLINA SURVEYING CO.
112 Manly St.
Greenville, S. C.

GCTC
FEB 13 1980 1122
900CI

217/61 123-9-31.1, 32, 33, 34, 35, 36 & 37