

MICROFILMED

NICHOLTOWN ROAD
WATER & SEWER IN RD. R/W

S 25-25E - S 26-35E

FILED
GREENVILLE


FEB 20 4 29 PM '80

DONNIE S. TANKERSLEY
R.M.C.


CLEVELAND FOREST
AVENUE

S 25

4' CHAIN
LINK FENCE

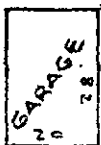

PT. 150 - PT. 150 - PT. 149 - PT. 149 -

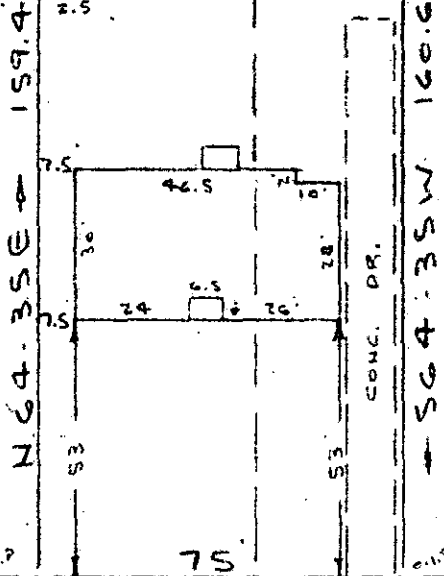

Note:
Improvements on this
lot are not in a
flood hazard area.

N 25-25W
TRAILS END
WATER & SEWER IN ST. R/W

PROPERTY OF

TIMOTHY A. LOVIN & SHAUNA B. LOVIN
GREENVILLE, SOUTH CAROLINA
SCALE: 1" = 40'
19 FEB 1980

GCTO
E2080
1368

This is to certify that on the 19th day of February, 1980, I surveyed the property shown on this plat, being known as part of lot 149 and part of lot 150 on plat of CLEVELAND FOREST and recorded in the RMC Office Greenville County, S. C., in Plat Book "H" at Page 37 and also being known as PROPERTY OF TIMOTHY A. LOVIN & SHAUNA B. LOVIN and recorded in the RMC Office Greenville County, S. C., in Plat Book at Page ; and that the property lines, walls and buildings are as shown hereon, and that the walls and buildings located on said lot do not encroach or project on adjacent street or property, and that no adjacent walls or buildings encroach or project on said premises, and no power lines cross this property except as shown hereon.

R. B. Bruce

25219

R. B. Bruce, RLS-71982

CAROLINA SURVEYING CO.
112 Manly St.
Greenville, S. C.

2V-50

3.0001