



AMENDED

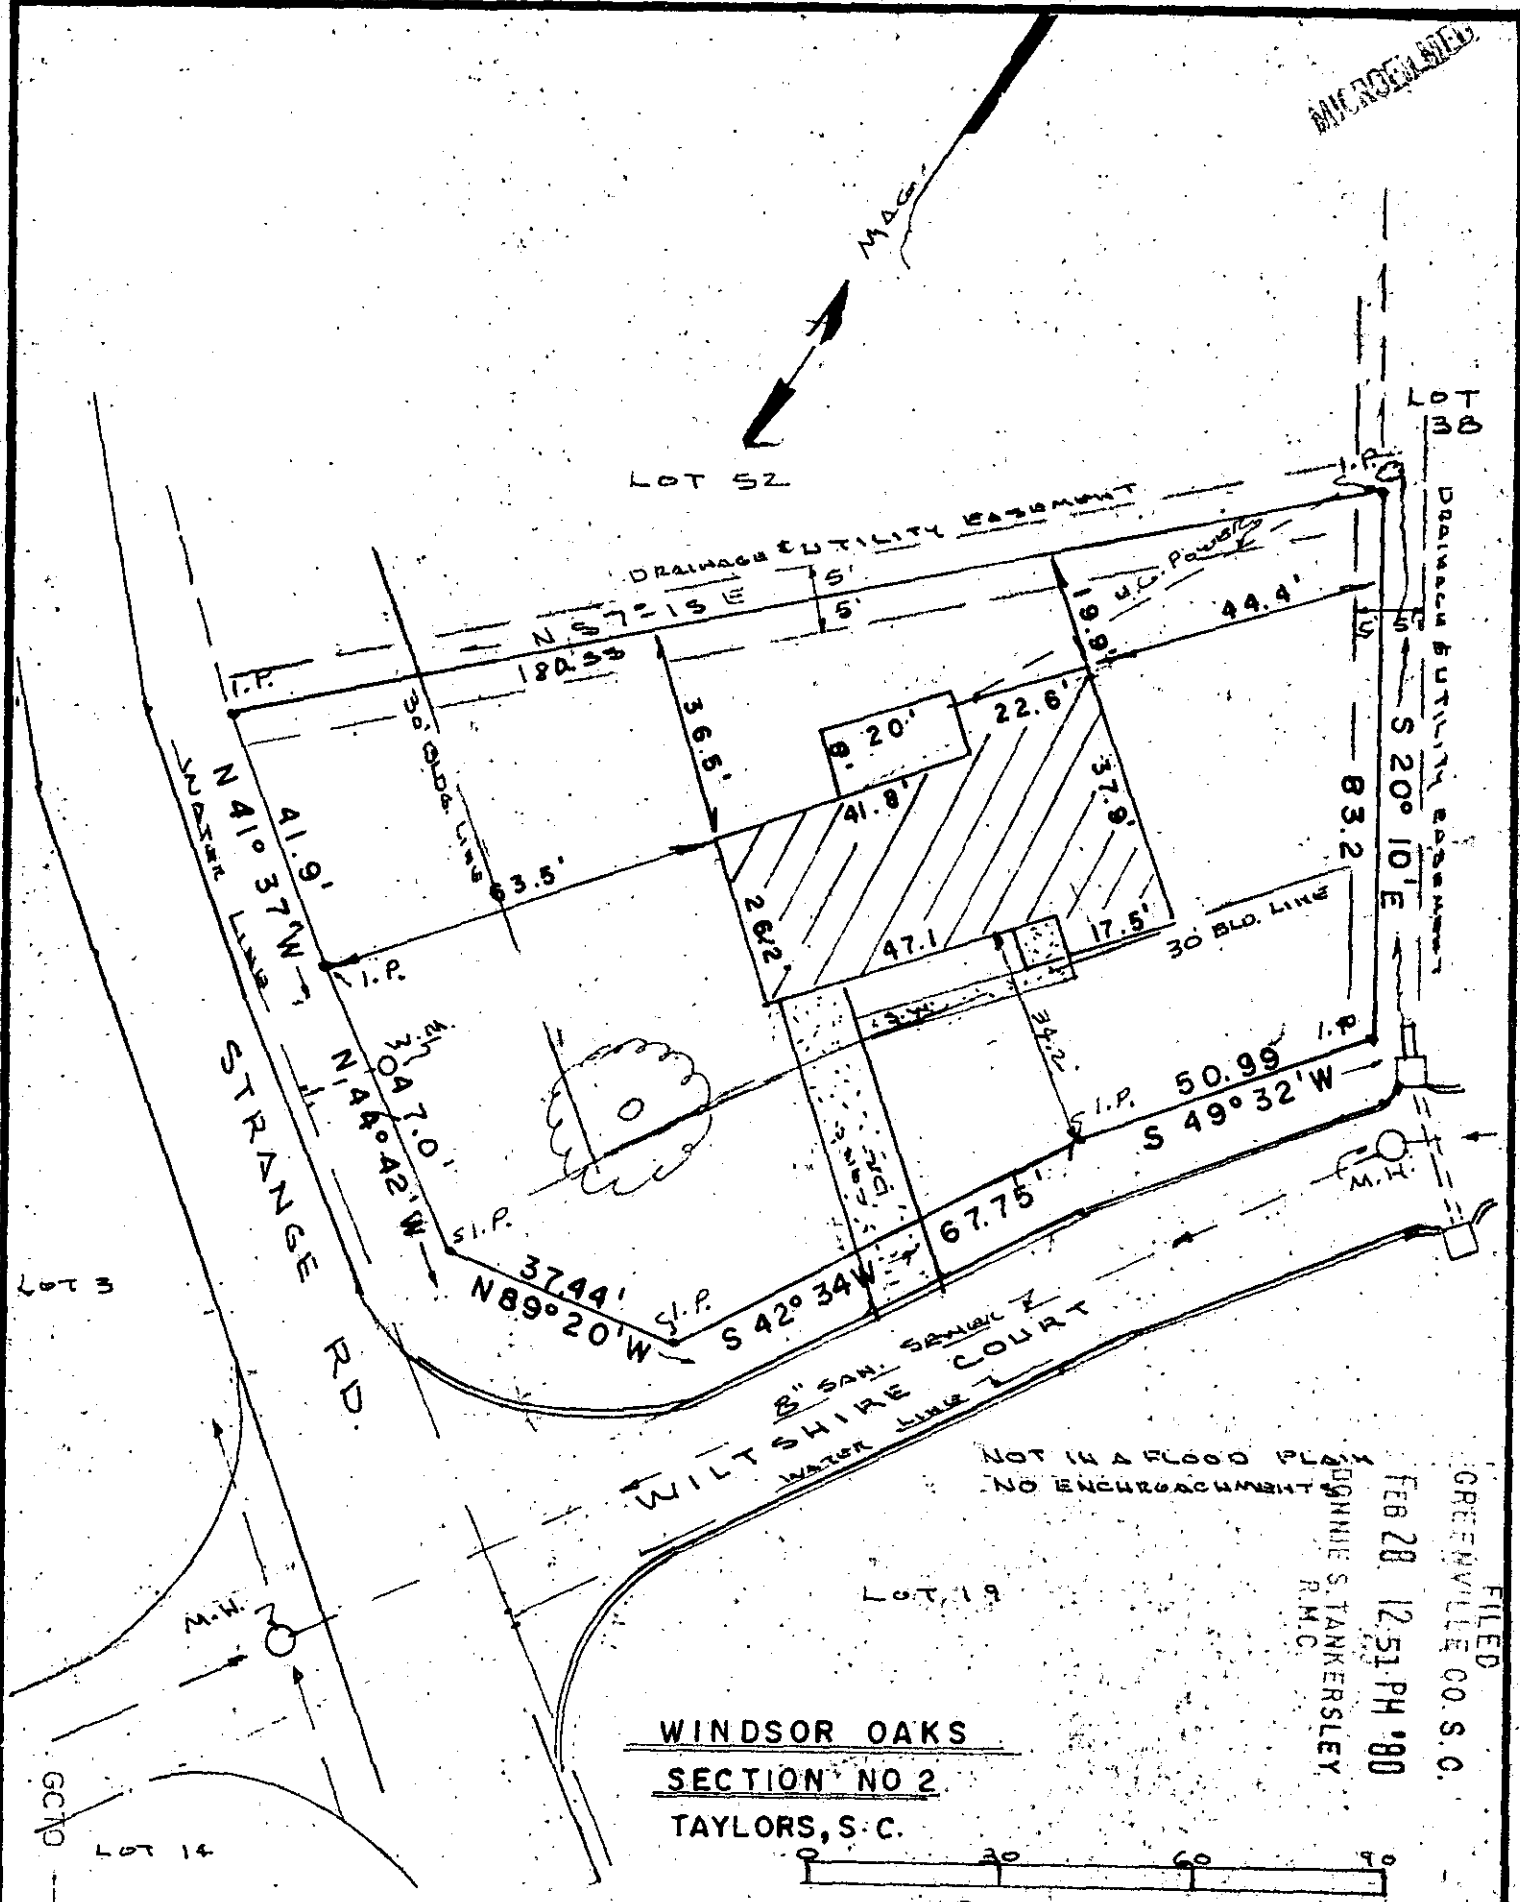

WINDSOR OAKS
SECTION NO 2
TAYLORS, S.C.

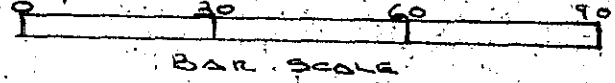

NOT IN A FLOOD PLAIN
 NO ENCROACHMENT

FILED
 GREENVILLE CO. S.C.
 FEB 28 12:51 PM '80
 DANNIE S. TANKERSLEY
 R.M.C.

25971 *Kenneth J. Gould*
 S.C. REG. NO 4035
 FEB 28 1980

7-V-83

581
 544



PROPERTY
 OF
LATIF AND ARMINDA S. MUGHAL

GOULD & ASSOC
 SURVEYORS
 TAYLORS, S.C.

Drawn By K.T.G. Sr.
 Checked By KG
 Scale 1" = 30'
 Date 2-16-80
 File No.
LOT NO. 18

ADJOURN LOT SURVEYED AND
 IS AS SHOWN.

3 FEB 28 1980

5-0001

[Handwritten signature]