AF 10505

MICROFILMED

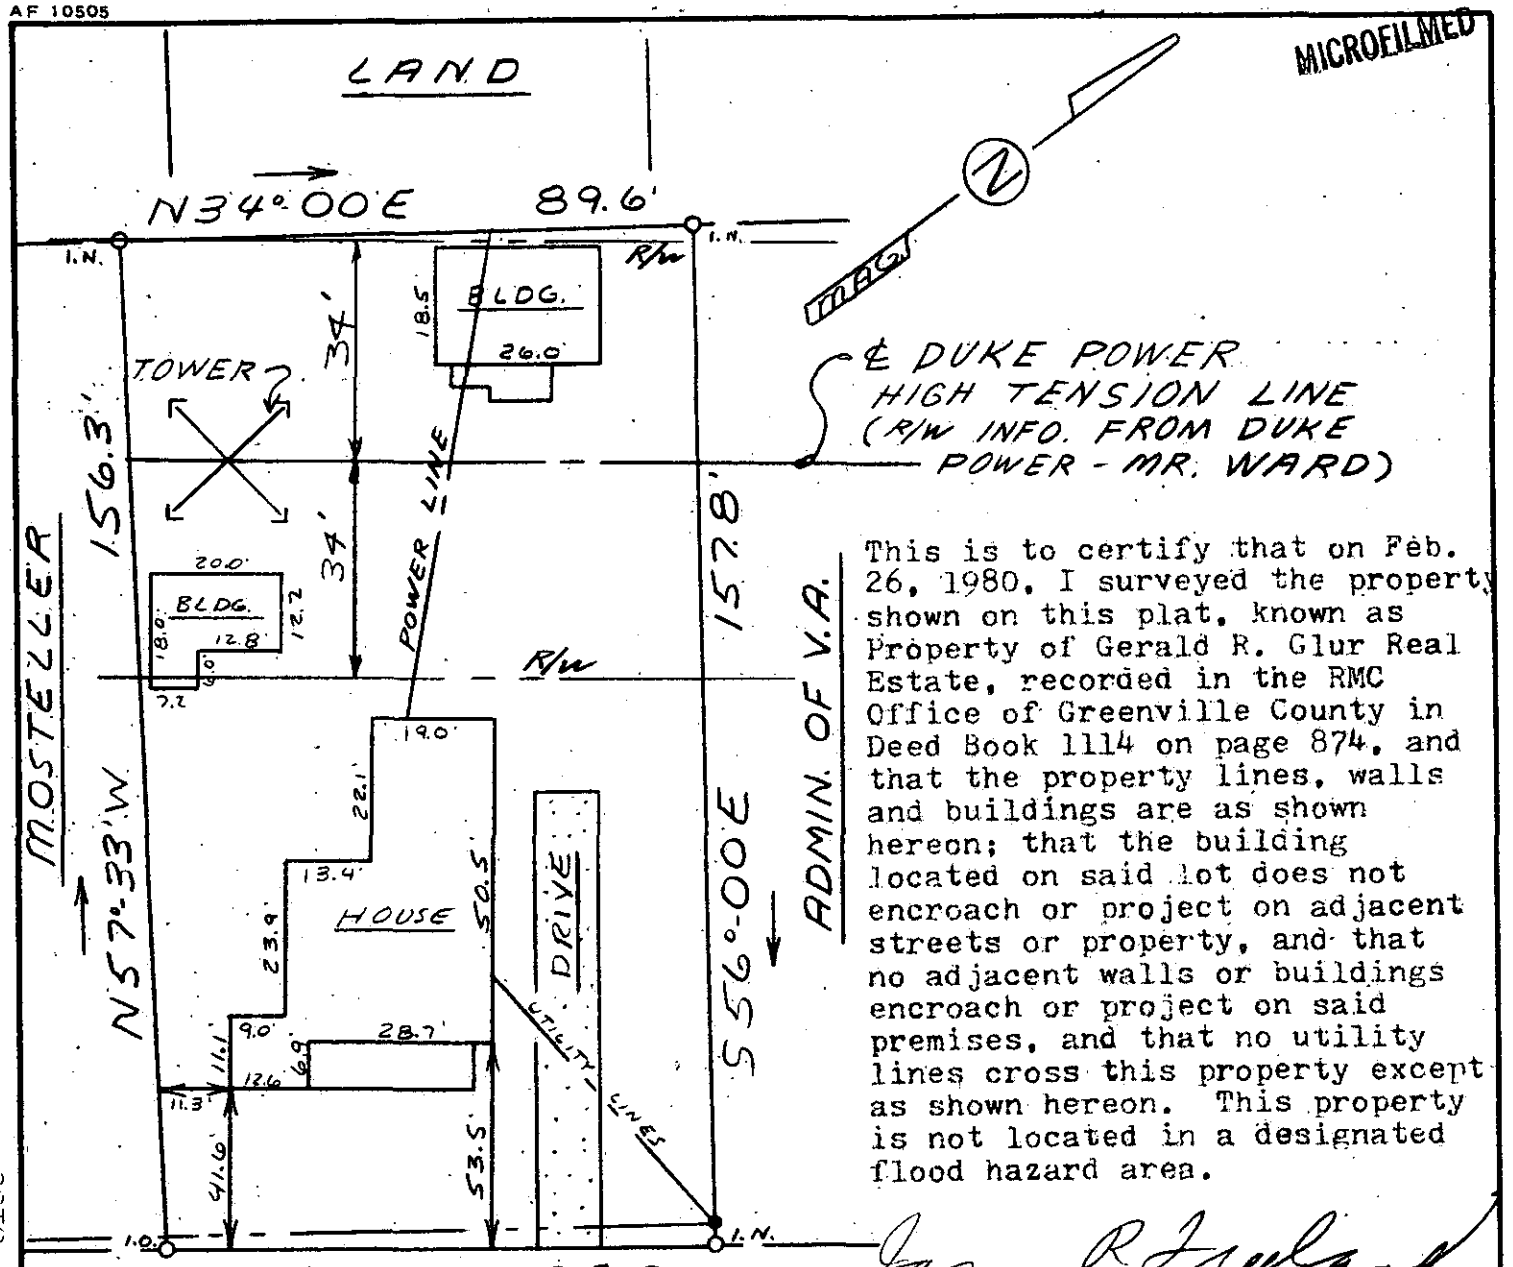

This is to certify that on Feb. 26, 1980, I surveyed the property shown on this plat, known as Property of Gerald R. Glur Real Estate, recorded in the RMC Office of Greenville County in Deed Book 1114 on page 874, and that the property lines, walls and buildings are as shown hereon; that the building located on said lot does not encroach or project on adjacent streets or property, and that no adjacent walls or buildings encroach or project on said premises, and that no utility lines cross this property except as shown hereon. This property is not located in a designated flood hazard area.

James R Freeland

James R. Freeland RLS & PE 4781

FILED
GREENVILLE CO. S.C.
FEB 29 2 58 PM '80
BONNIE S. TANKERSLEY
R.M.C.

FEB 29 1980 26140

7-V-90

235-4-1 A.

SOUTH CAROLINA
REGISTERED LAND SURVEYOR
No. 4781
JAMES RALPH FREELAND

SEAL

STATE OF SOUTH CAROLINA
GREENVILLE COUNTY

PROPERTY OF

DAVID WALTER BOUVIER

HO YONG BOUVIER

FREELAND & ASSOCIATES
Engineers • Land Surveyors
GREENVILLE, S.C.

SURVEY	DCH
DRAWN	M.C.
CHECK	M.C.
SCALE	1" = 30'
DATE	2-26-80
DWG. NO.	80-4800

GCTO --- 1 FE29 80 1055

3.00CI