


FILED
GREENVILLE CO. S. C.

TAYLORS ROAD

MAR 31 AM '88

DONNY S. TANKERSLEY
R.M.C.

MICROFILMED

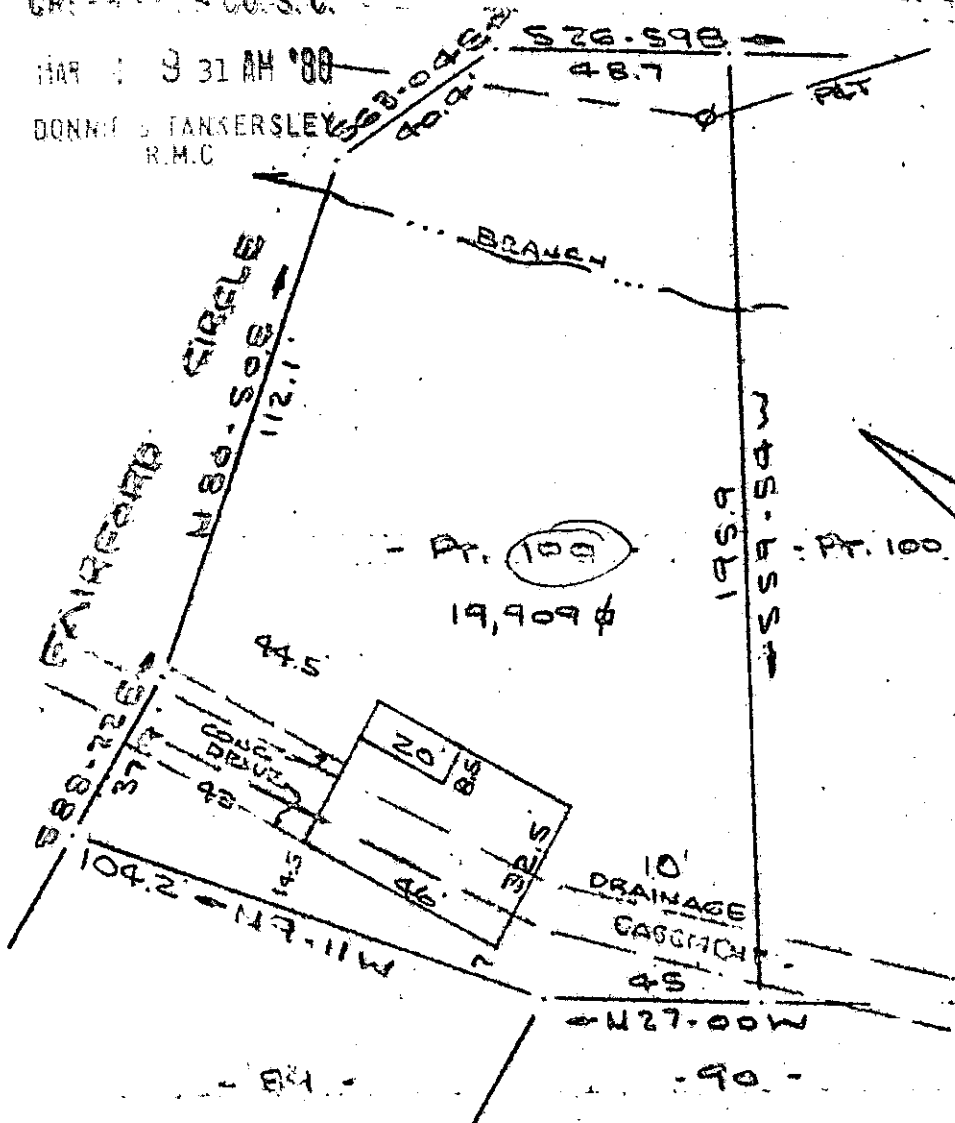

PROPERTY OF
MARY W. WATERS
NEAR GREENVILLE, S. C.
SCALE: 1" = 40'
20 NOV 1979

26322 ✓

7V-94

R. B. [Signature]

CAROLINA SURVEYING CO.
117 MANLY ST.
GREENVILLE, S.C. 29601

SOUTH CAROLINA
RECORDS AND DEEDS
3,000

LB

T 34.1 - 2 - Pt. 73