


FILED  
 GREENVILLE CO. S.C.  
 MAR 4 3 04 PM '80  
 DONNIE S. TANKERSLEY  
 R.M.C.

This is to certify that on February 29, 1980, I surveyed the property shown on this plat known as an undeveloped area on plat of Marshall Forest recorded in the RMC Office of Greenville County in Deed Book 808 page 522, and that the property lines, walls, and buildings are as shown hereon; that the building located on said lot does not encroach or project on adjacent streets or property, and that no adjacent walls or buildings encroach or project on said premises, and that no utility lines cross this property except as shown hereon. This house is not located in a designated flood hazard area.

*James R. Freeland*  
 James R. Freeland RLS & PE 4781

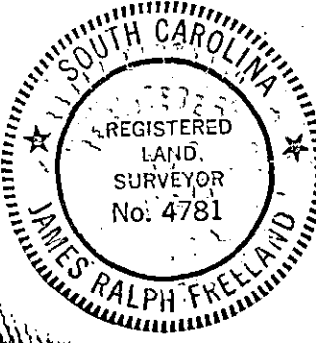

STATE OF SOUTH CAROLINA  
 GREENVILLE COUNTY

PROPERTY OF  
RONALD L. GREEN JR.  
PAMELA W. GREEN

FREELAND & ASSOCIATES Engineers • Land Surveyors	
GREENVILLE, S.C.	
SURVEY	DH
DRAWN	JRF
CHECK	
SCALE	1" = 50'
DATE	2-29-80
DWG. NO.	80-4818

SEAL