

FILED

GREENVILLE CO. S. C.


MAR 10 12 53 PM '80

DONNIE S. TANKERSLEY
R.M.C.

124

BRAMBLE CT.

MAG. NORTH

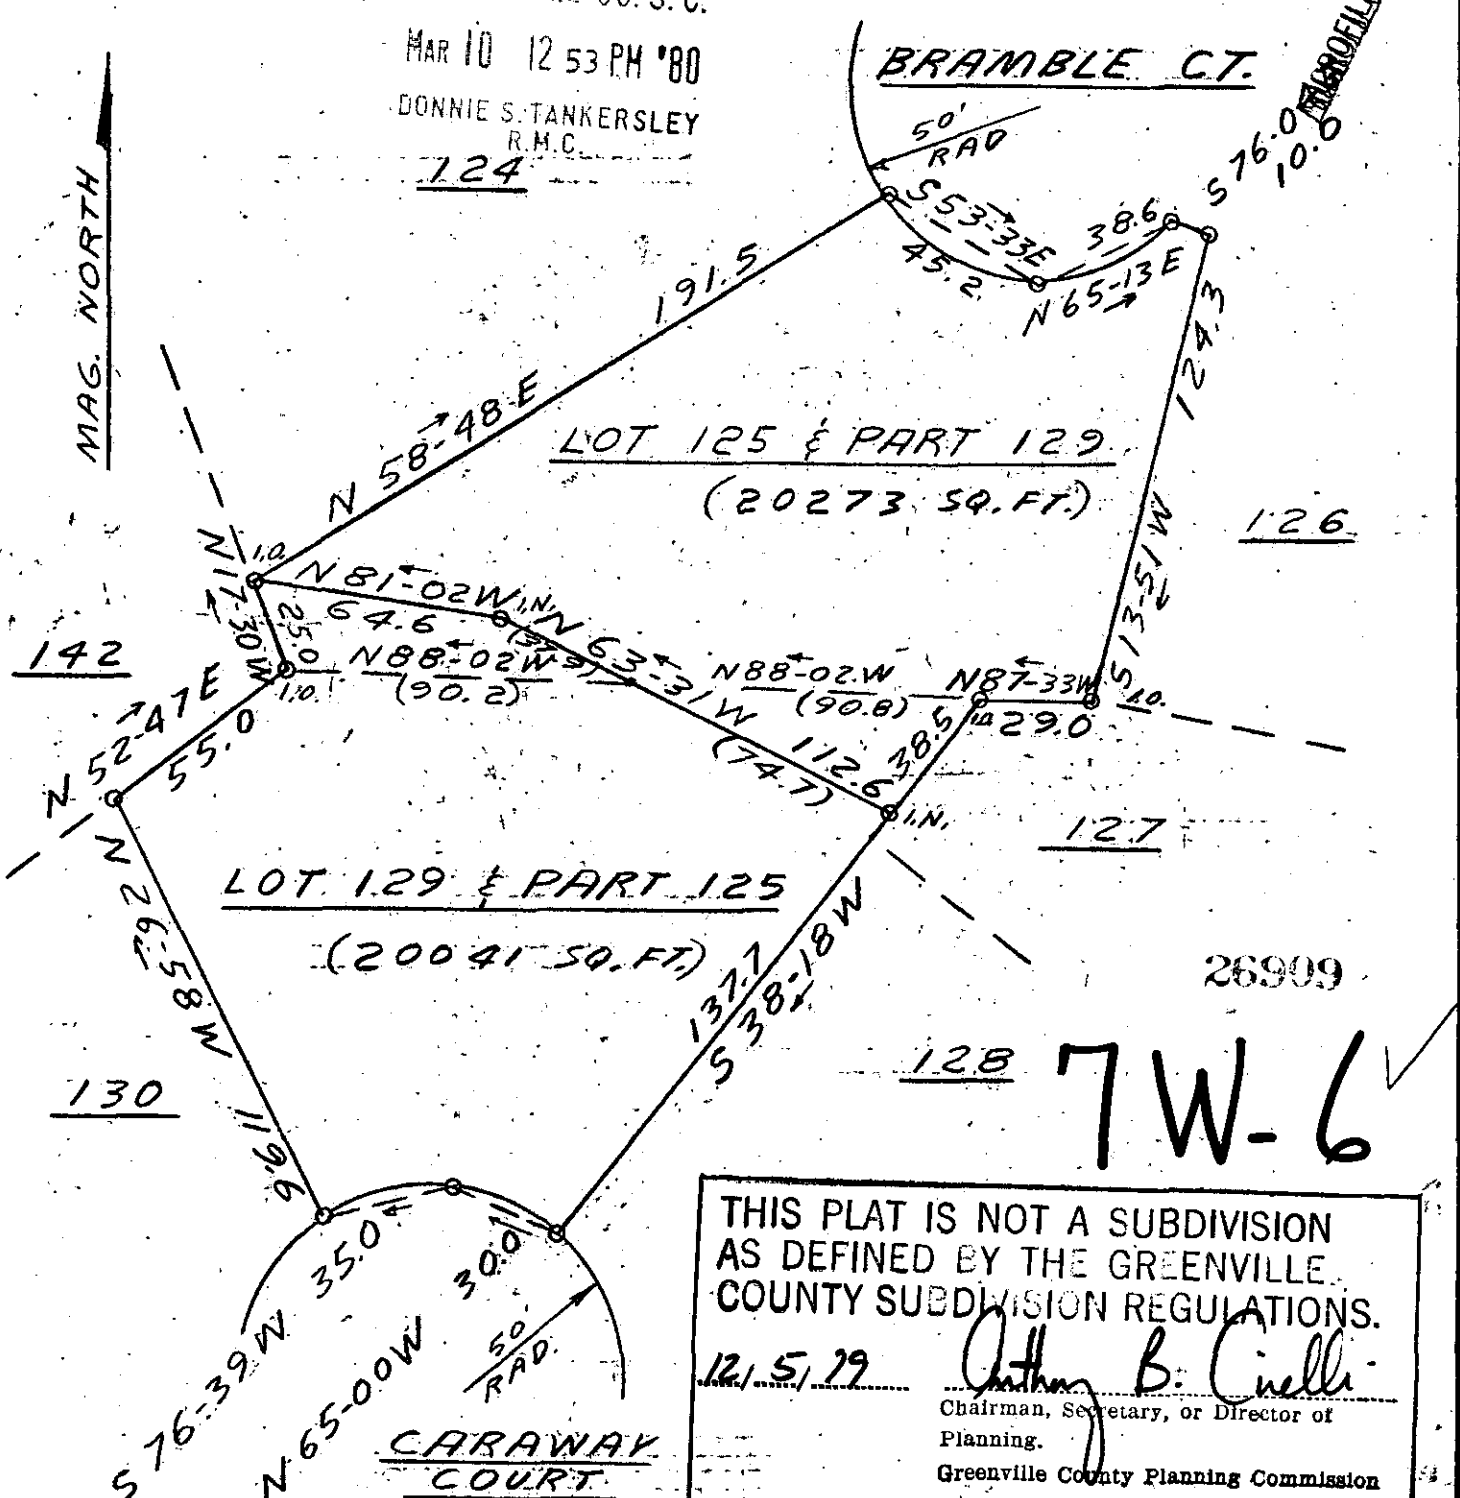

THIS PLAT IS NOT A SUBDIVISION
AS DEFINED BY THE GREENVILLE
COUNTY SUBDIVISION REGULATIONS.

12/5/79 *Anthony B. Cielli*
Chairman, Secretary, or Director of
Planning.
Greenville County Planning Commission



STATE OF SOUTH CAROLINA
GREENVILLE COUNTY

DOVE TREE
REVISION OF
LOT 125 & LOT 129
LOT LINE CHANGE ONLY

FREELAND & ASSOCIATES
Engineers • Land Surveyors

GREENVILLE, S.C.

SURVEY DA
DRAWN: JRF
CHECK: ML
SCALE: 1" = 50'
DATE: 12-5-79
DWG. NO.: 7-9-4502