

This is to certify that on March 20, 1980, I surveyed the property shown on this plat, known as Lot 34 on plat of Rosedale, recorded in the RMC Office of Greenville County in Plat Book QQ on page 113, and that the property lines, walls and buildings are as shown hereon; that the building located on said lot does not encroach or project on adjacent streets or property, and that no adjacent walls or buildings encroach or project on said premises, and that no utility lines cross this property except as shown hereon. This property is not located in a designated flood hazard area.

5' drainage and utility easement each side of all side and rear lot lines.


James R. Freeland
 James R. Freeland RLS & PE

FILED
 GREENVILLE CO. S.C.
 3 25 PM '80
 DONNIE STANLEY
 CLERK R.M.C.

28414

MAR 25 1980 of 7-W-50 ✓

SCTO --- 1 MR25 80 1483 3.00CI

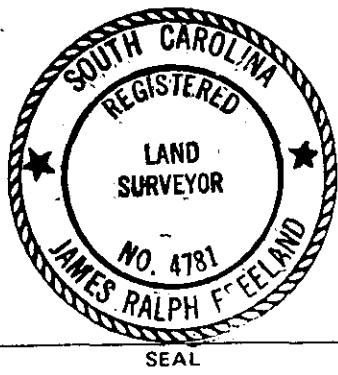

STATE OF SOUTH CAROLINA
GREENVILLE COUNTY

ROSEDALE
LOT 34
PROPERTY OF
DAVID L. VASSY JR.
REBECCA G. VASSY

FREELAND & ASSOCIATES
 Engineers • Land Surveyors
 GREENVILLE, S.C.

SURVEY V B
 DRAWN JRF
 CHECK M.C.
 SCALE 1" = 40'
 DATE 3-20-80
 DWG. NO. 80-4888