


MICROFILMED

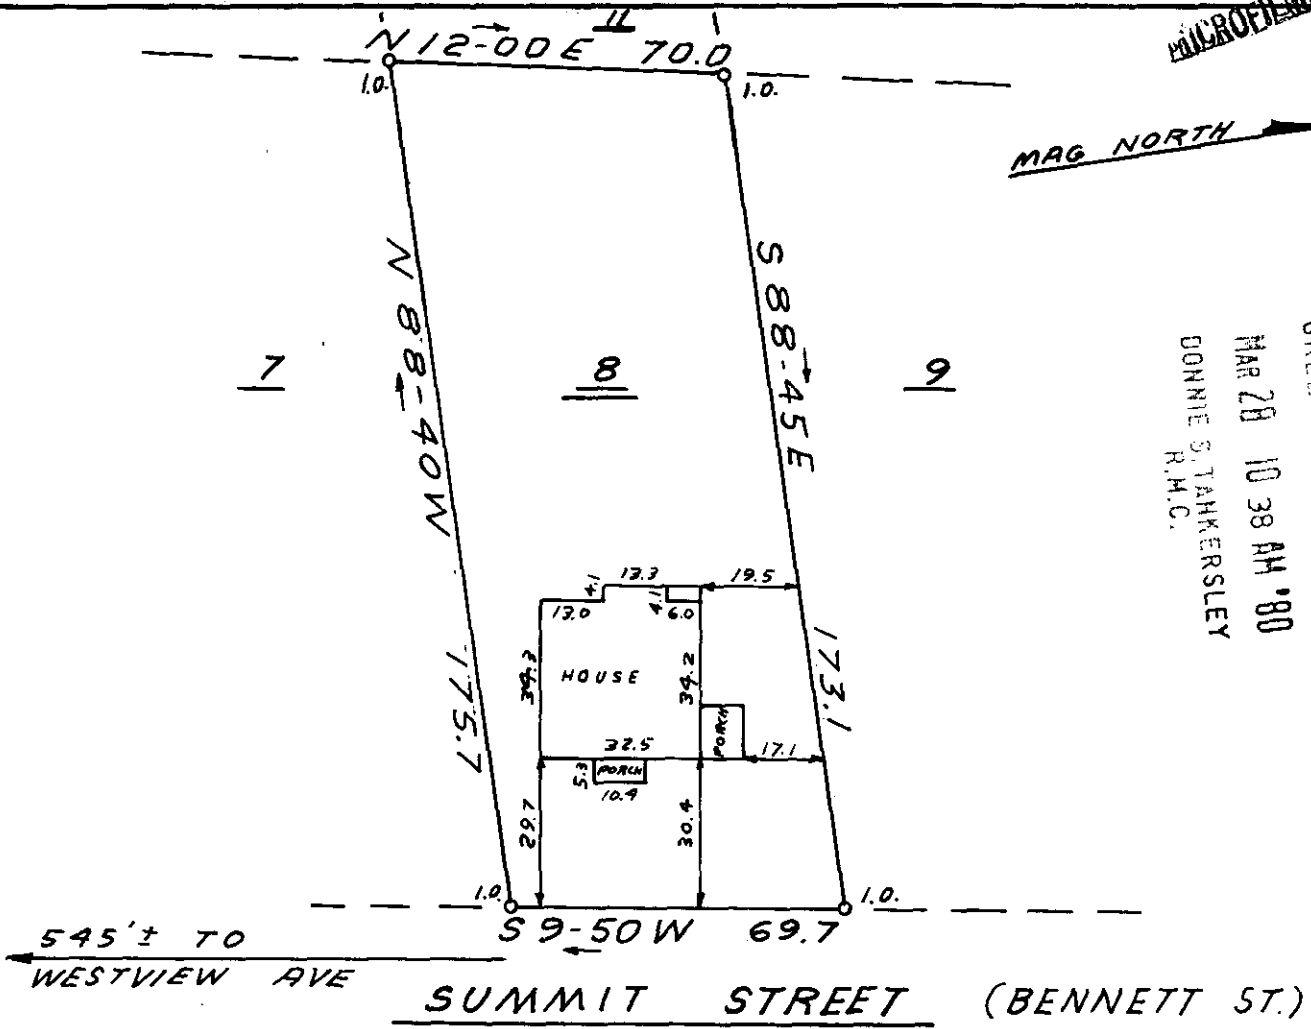

MAG NORTH

FILED  
 GREENVILLE CO. S.C.  
 MAR 28 10 38 AM '80  
 DONNIE S. TANKERSLEY  
 R.M.C.

This is to certify that on March 25, 1980, I surveyed the property shown on this plat, known as Lot 8 on plat of Parkvale Sec. A Block 1, recorded in the RMC Office of Greenville County in Plat Book K on page 52, and that the property lines, walls and buildings are as shown hereon; that the building located on said lot does not encroach or project on adjacent streets or property, and that no adjacent walls or buildings encroach or project on said premises, and that no utility lines cross this property except as shown hereon. This property is not located in a designated flood hazard area.

28859

*James R Freeland*

James R. Freeland RLS & PE 4781

MAR 28 1980

7-W-58 ✓

3 MR28 80 1514



STATE OF SOUTH CAROLINA  
 GREENVILLE COUNTY

PARKVALE  
 SECT. "A" - BLOCK 1 - LOT 8

PROPERTY OF  
KEITH S. TOBIAS  
KAREN A. TOBIAS

|   |          |
|---|----------|
| FREELAND & ASSOCIATES<br>Engineers & Land Surveyors |          |
| GREENVILLE, S.C.                                    |          |
| SURVEY  | 27       |
| DRAWN   | JRF      |
| CHECK   | JRF      |
| SCALE   | 1" = 40' |
| DATE  | 3-25-80  |
| DWG. NO.  | 80-4904  |