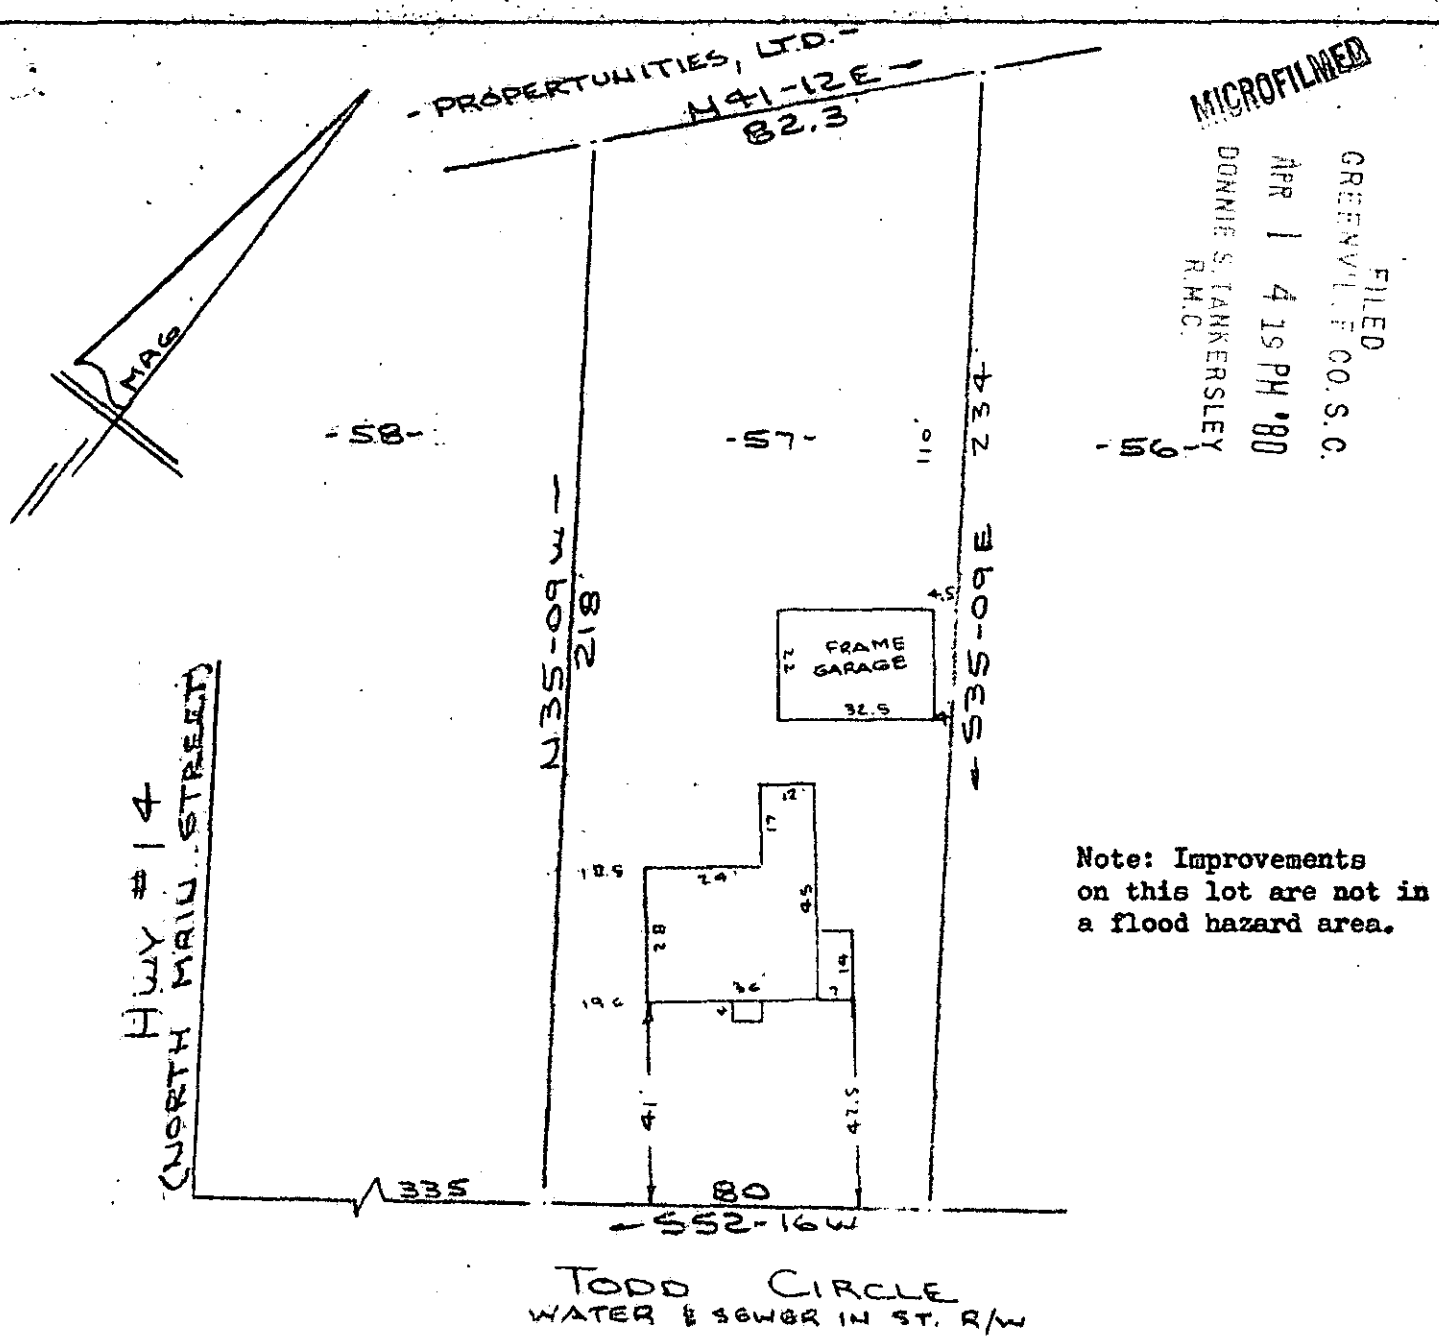

MICROFILMED

FILED
GREENVILLE CO. S.C.
APR 1 4 15 PM '80
DONNIE S. TANKERSLEY
R.M.C.

Note: Improvements on this lot are not in a flood hazard area.

PROPERTY OF

ROGER G. TERRY & NANCY H. TERRY

SIMPSONVILLE, S.C.

SCALE: 1" = 40 25 MAR 1980

This is to certify that on the 25th day of March, 1980, I surveyed the property shown on this plat, being known as lot 57 on plat of ROLAND HEIGHTS and recorded in the RMC Office Greenville County, S. C., in Plat Book " S " at Page 34; and that the property lines, walls and buildings are as shown hereon, and that the walls and buildings located on said lot do not encroach or project on adjacent street or property, and that no adjacent street or property, and that no adjacent walls or buildings encroach or project on said premises, and no power lines cross this property except as shown hereon.

29167

7-W-68

APR 1 1980

R. B. Bruce, RLS #1952

CAROLINA SURVEYING CO.
112 Manly St., Greenville, S.C.

GCTO ----- 3 AP.1 80 1550

3.00CI

224/20-A

303-1-5