


I, AARON M. THOMPSON HEREBY CERTIFY THAT THIS PLAT REPESENTS A SURVEY MADE ON THE GROUND LINDER MY SUPERVISION ON MAY 29, 1980 AND AT THE TIME OF THIS SURVEY THERE WERE NO ENCROACHMENTS OTHER THAN, SHOWN.

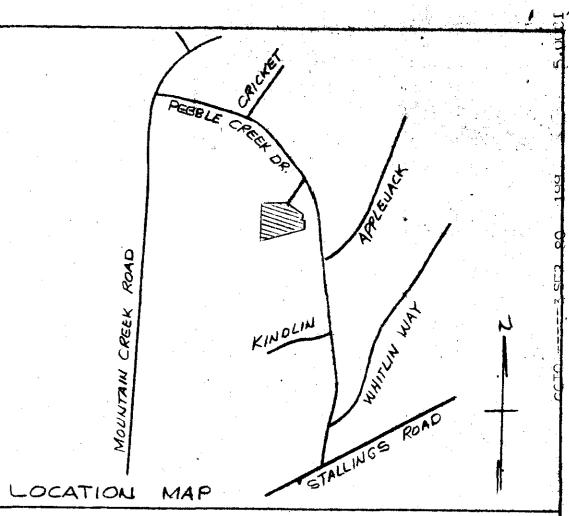

# FINAL PLAT

### CERTIFICATE OF OWNERSHIP AND DEDICATION

"The undersigned hereby acknowledge that I am (we are) the owner(s) of the property shown and described hereon and that I (we) hereby adopt this plan of subdivision with my (our) free consent and that I (we) establish the minimum building restriction lines, and hereby dedicate to public use as roads, streets, and essements, forever all areas so shown or indicated on said plat.

3/21/80	Signed Halloway
/	Signed
	Signed

#### CERTIFICATE OF ACCURACY

"I. ARON M. THOMPSON, certify that this plat was (drawn by me) (drawn under my supervision) (an actual survey made under my supervision) from (an actual survey by me) (deed description recorded in Book 11/8 etc.) (other); that the error of closure as calculated by fatitudes and departures is 1/5000 , that the boundaries not surveyed are shown as broken lines plotted from information found in Book , Page ; that this plat was prepared in accordance with the Greenville County Subdivision Regulations as

<b>.</b>	
3-21-80	1
DATE	

LICENSED ENGINEER OR REGISTERED SURVEYOR

S. C. Registration No. 3616

## CERTIFICATE OF APPROVAL FOR RECORDING

"I hereby certify that the subdivision plat shown hereon has been found to comply with the Subdivision Regulations for Greenville County, with the exception of such variances, if any, as are noted in the minutes of the Greenville County Planning Commission of Greenville County, South Carolina, and that it has been approved for recording in the office of the County Register of Mense Conveyance."

APRIL	14	1
	ATE .	

DIRECTOR OF PLANNING
GREENVILLE COUNTY PLANNING COMMISSION

# FILE NUMBER

FOUNDATION SURVEY BLACKBERRY COURT GREENVILLE CO., S. C.

ACADEMY RENTAL COMPANY	
OWNER	

PIEDMONT SURVEYORS SURVEYOR

NO. OF ACRES: 2.63

FOUNDATIONS ADDED MAY 29, 1980

MILES .032

NO. OF LOTS: 10

DATE: 3/21/80

GEND DRAINAGE EASEMENT AS SHOWN SAN. SEWER RIW AS SHOWN