


MICROFILMED

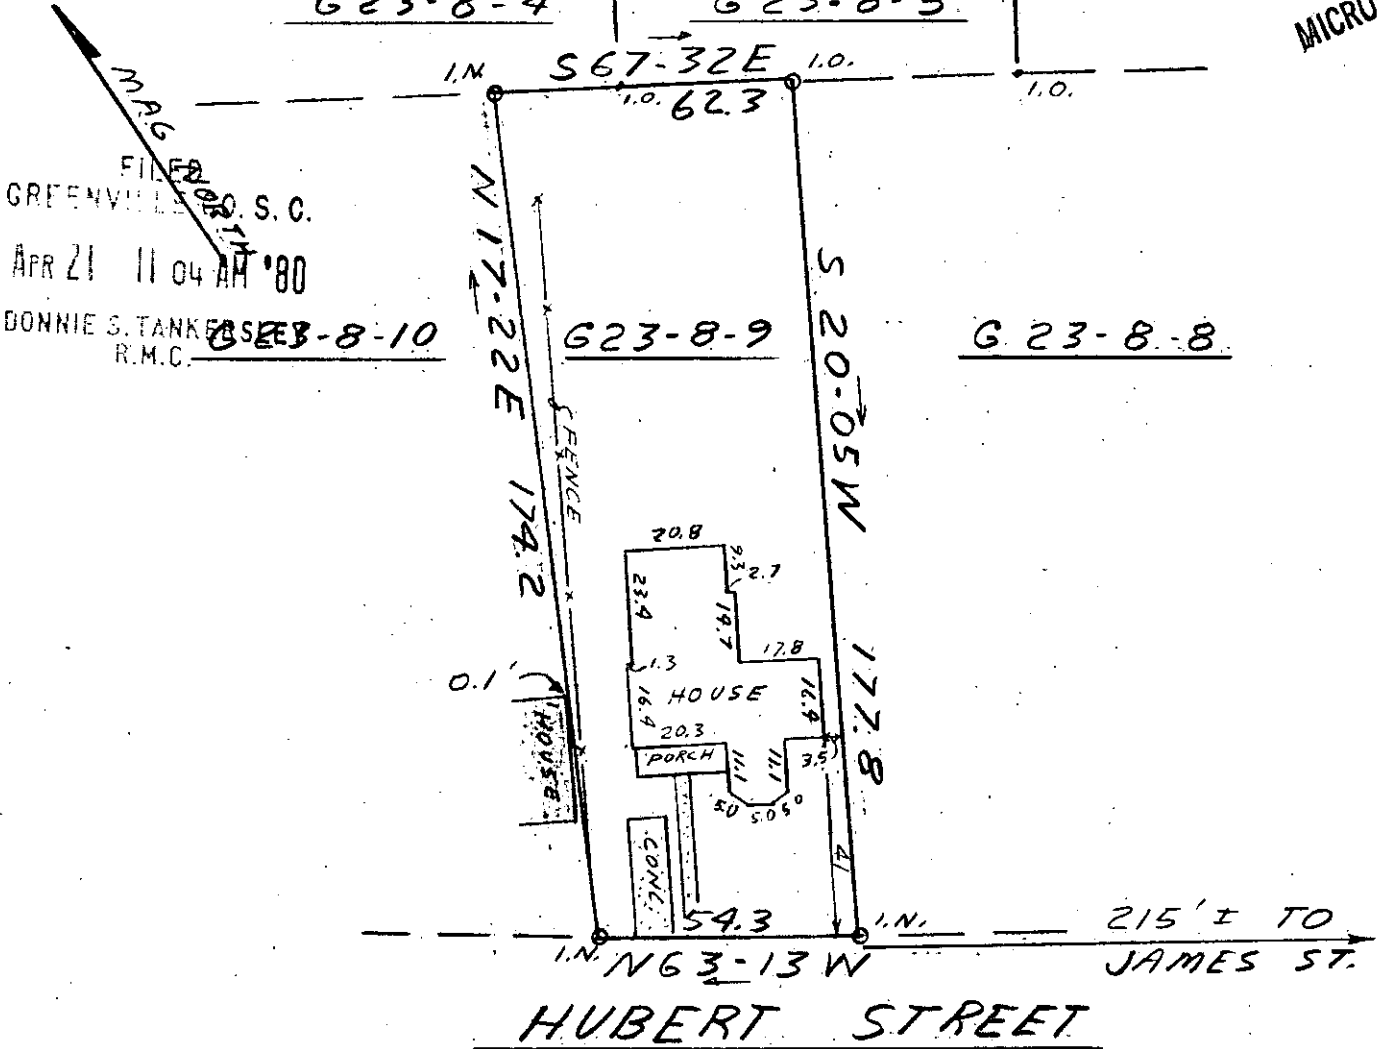

FILED
 GREENVILLE, S.C.
 APR 21 11 04 AM '80
 DONNIE S. TANKE
 R.M.C.

This is to certify that on April 17, 1980, I surveyed the property shown on this plat, known as Property of F.E. Cooper, recorded in the RMC Office of Greenville County in Deed Book 400 on page 269, and that the property lines, walls and buildings are as shown hereon; that the building located on said lot does not encroach or project on adjacent streets or property, and that no adjacent walls or buildings encroach or project on said premises, and that no utility lines cross this property except as shown hereon. This property is not located in a designated flood hazard area.

30930

James R. Freeland
 James R. Freeland RLS & PE 4781

APR 21 1980

7-2-24 ✓



STATE OF SOUTH CAROLINA
 GREENVILLE COUNTY
 PROPERTY OF
ARTHUR J. STERLING
HATTIE B. STERLING

FREELAND & ASSOCIATES
 Engineers • Land Surveyors
 GREENVILLE, S.C.
 SURVEY MC
 DRAWN JRF
 CHECK RP
 SCALE 1" = 40'
 DATE 4-17-80
 DWG. NO. 80-4970

APR 21 1980

SEAL