

MICROFILMED

WOODY CREEK RD.

407.3' TO SUGAR CREEK RD.

S 32-34 W 110.0

25

LOT 390

S 57-26 E 140.0

N 57-26 W 140.0

LOT 392

LOT 391

LOT 58

LOT 57

SAN. SEWER

U.G. Elec  
U.S. TEL.

N 32-34 E 110.0

PROPERTY OF

ROBERT G. & PATRICIA J. FREDERICK  
NEAR GREENVILLE, S.C.

SCALE 1" = 30'

MAY 2, 1980

32585

REF: LOT NO. 391 ON PLAT OF  
MAP NO. 1, SECTION 2, SUGAR  
CREEK, RECORDED IN PLAT BOOK  
7C PAGE 68.

NOTE: DRAINAGE AND UTILITIES  
EASEMENT 5' EACH SIDE OF  
SIDE AND REAR LOT LINES.


I certify that this is an accurate map of a survey made by me May 2nd 1980,  
that the improvements located on said premises do not encroach or project  
on adjacent streets or property, that no easements are visible on the ground  
except as noted hereon, and that the structures located on said premises  
are not in a designated flood plain based on the public records of  
Greenville County.

7-2-68

MAY 7, 1980

*C. O. Riddle*

R.L.S. # 1347, Greenville, S.C.

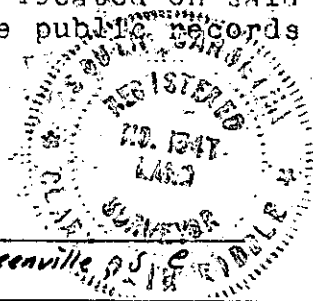

FILED  
GREENVILLE CO. S.C.  
MAY 7 10 02 AM '80  
DANNIE S. TANKERSLEY  
R.M.C.

1000.3