


MICROFILMED

FILED  
GREENVILLE CO. S.C.  
MAY 9 3 01 PM '80  
DONNIE S. TANKERSLEY  
R.M.C.

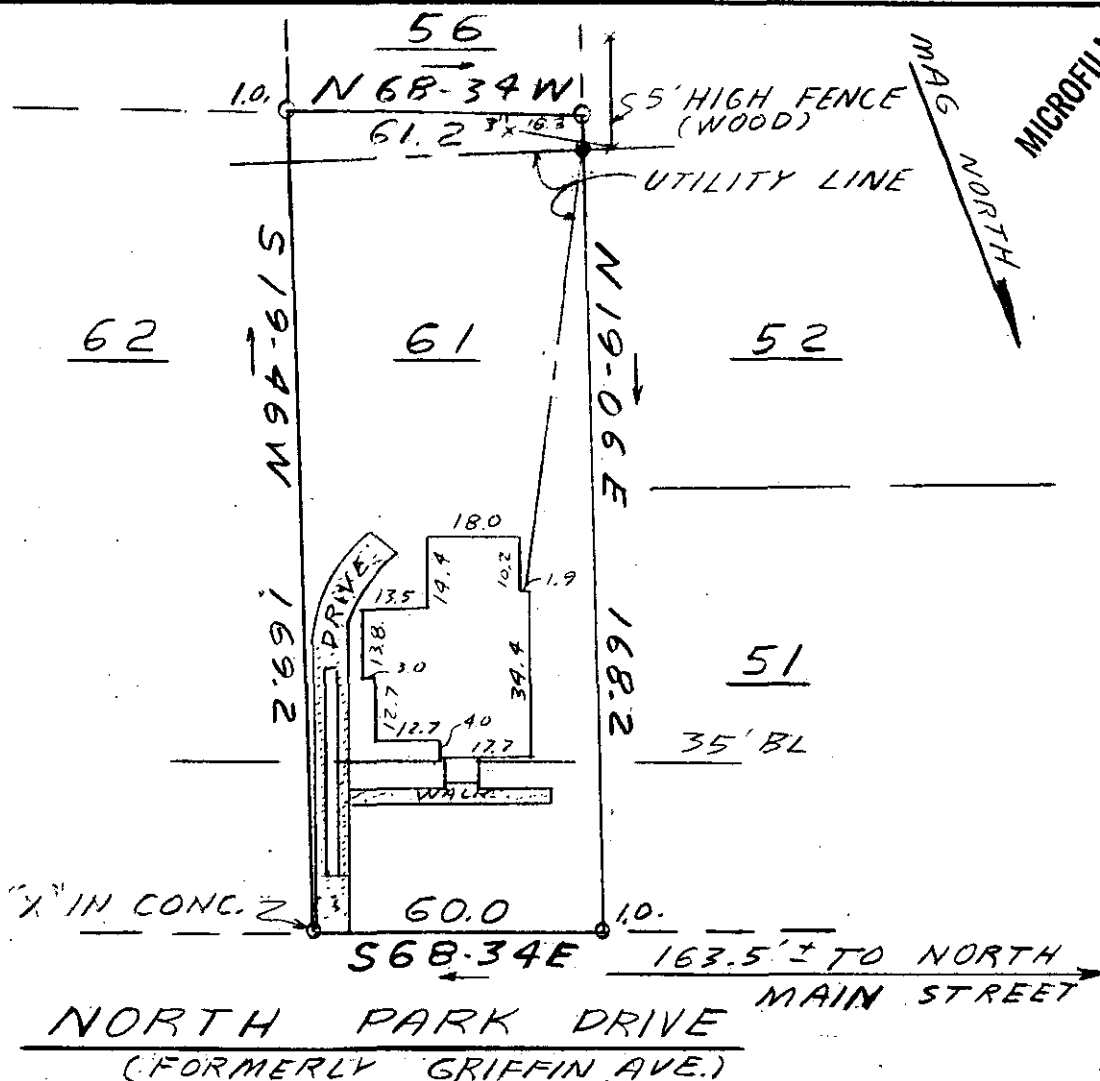

This is to certify that on May 7, 1980, I surveyed the property shown on this plat, known as Lot 61 on plat of North Park, recorded in the RMC Office of Greenville County in Plat Book K on page 49, and that the property lines, walls and buildings are as shown hereon; that the building located on said lot does not encroach or project on adjacent streets or property, and that no adjacent walls or buildings encroach or project on said premises, and that no utility lines cross this property except as shown hereon. This property is not located in a designated flood hazard area.

32844

✓ 7-2-76

*James R. Freeland*  
James R. Freeland RLS & PS 4781

178-9-1 MAY 9 1980



STATE OF SOUTH CAROLINA  
GREENVILLE COUNTY

NORTH PARK  
LOT 61  
PROPERTY OF  
WARREN M. WEBER  
CYNTHIA J. WEBER

FREELAND & ASSOCIATES  
Engineers • Land Surveyors

GREENVILLE, S.C.

SURVEY MC  
DRAWN J.R.F.  
CHECK J.R.F.  
SCALE 1" = 40'  
DATE 5-7-80  
DWG. NO. 5023

SC10 -- 1 MY 9 80 145 3.00CI