

MICROFILMED

PIEDMONT GOLF COURSE ROAD

S 79-47 E 284.26'

I.P.O.

MELLYN ST
S 11-53 W 300.89'

1.966 Acres


LOT NO. 10
N 12-01 E 301.16'



N 79-50 W 285'
LOT 44 - HASELWOOD SEC. 3

REF: LOT NO. 9 ON PLAT OF HASELWOOD RECORDED IN PLAT BOOK TTT PAGE 25 A

33482

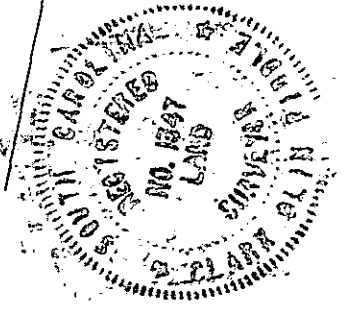

I CERTIFY THAT THE RATIO OF PRECISION OF THE FIELD SURVEY IS 1/37,000 AND AREA WAS COMPUTED BY D.M.D. METHOD.

SURVEY FOR
VANCE B. DRAWDY
NEAR MOONVILLE - GREENVILLE COUNTY S.C.
SCALE 1" = 60'
MAY 7, 1980

7-2-98 ✓



C.O. Riddle - R.L.S.#1297 - Greenville S.C.

MAY 16 1980

3.0000

MAY 16 4 12 PM '80
DONNIE STANKERSLEY
R.M.C.

GREENVILLE CO. S.C.