


MICROFILMED

FILED
GREENVILLE CO. S. C.



AUG 29 12 05 PM '80

DONNIE S. TANKERSLEY
R.M.C.

Note:
Reference Plat Book 4R - Pg. 17,
Deed Books 1049 - Pg. 934,
1076 - Pg. 512, 972 - Pg. 277,
1077 - Pg. 264.

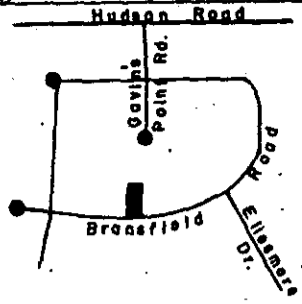

Location Map
N.T.S.

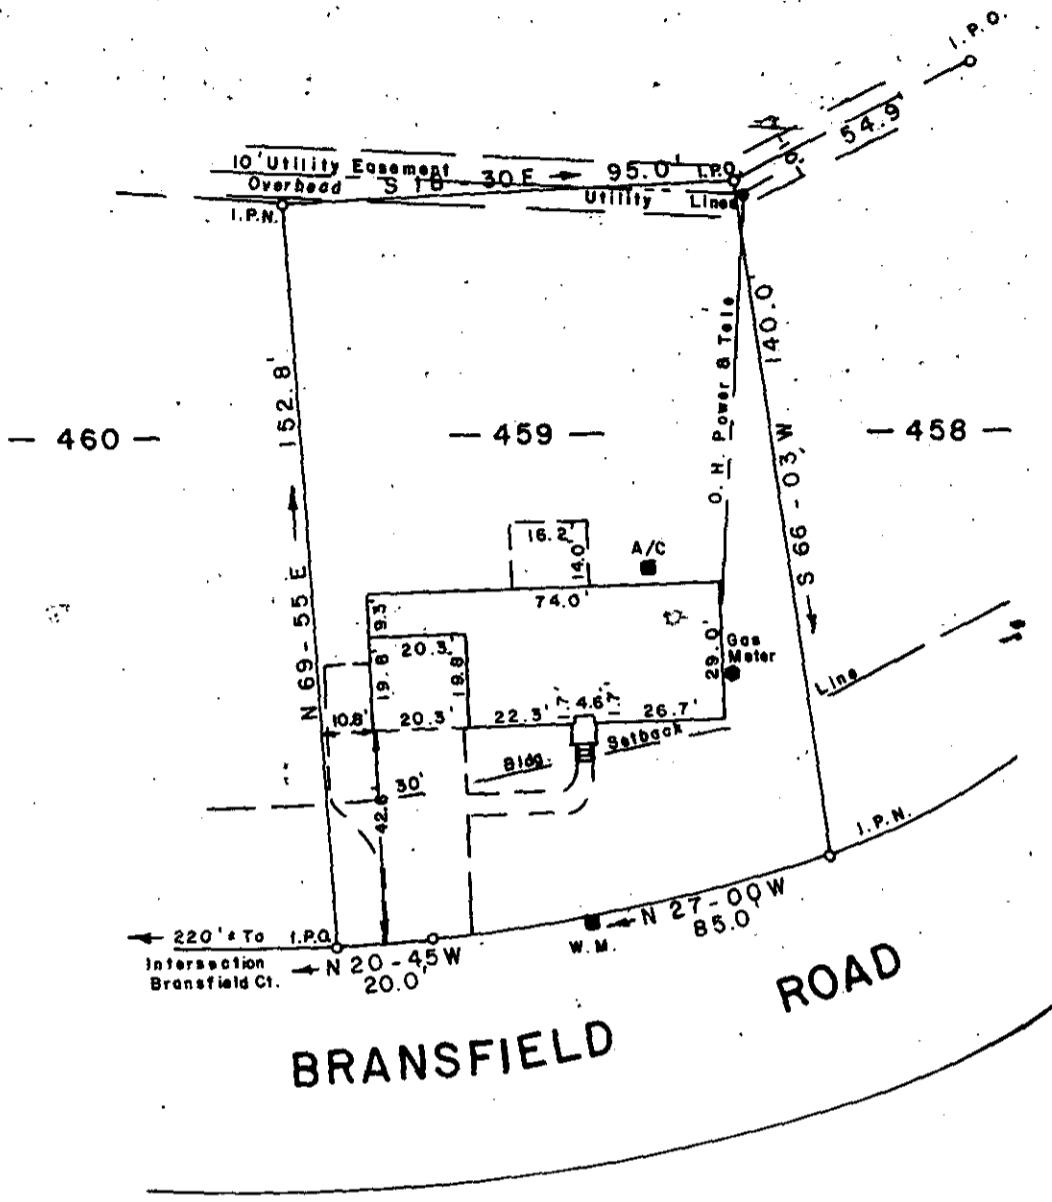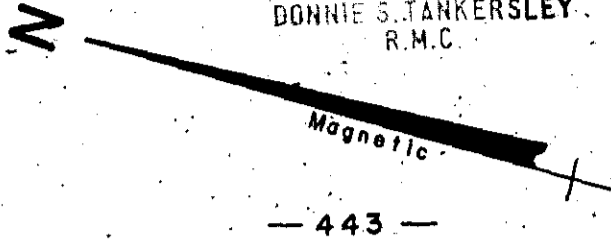

Section No. V Del Norte Estates

SURVEY FOR
NEIL SIMMONS
MARIANNA SIMMONS
NEAR GREENVILLE
GREENVILLE COUNTY
SOUTH CAROLINA
AUGUST 25, 1984


JA-90

6563

JEFFERY M. PLUMBLEE
REGISTERED LAND SURVEYOR
SOUTH CAROLINA
P. O. BOX 788
TRAVELERS REST, S.C. 29690 (803) 834-4426

I Herby Certify That The Measurements As
Shown Above Are Correct And There Are No
Encroachments Or Projections Other Than
Shown.

Jeffery M. Plumblee

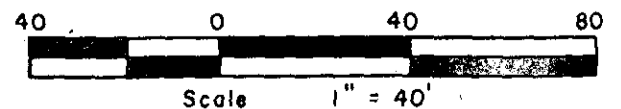

GCTO AL29 80 1569