FILED
GREENVILLE CO. S. C.
MAY 26 10 03 AM '80
DONNIE S. TANKERSLEY
R.M.C

MICROFILMED

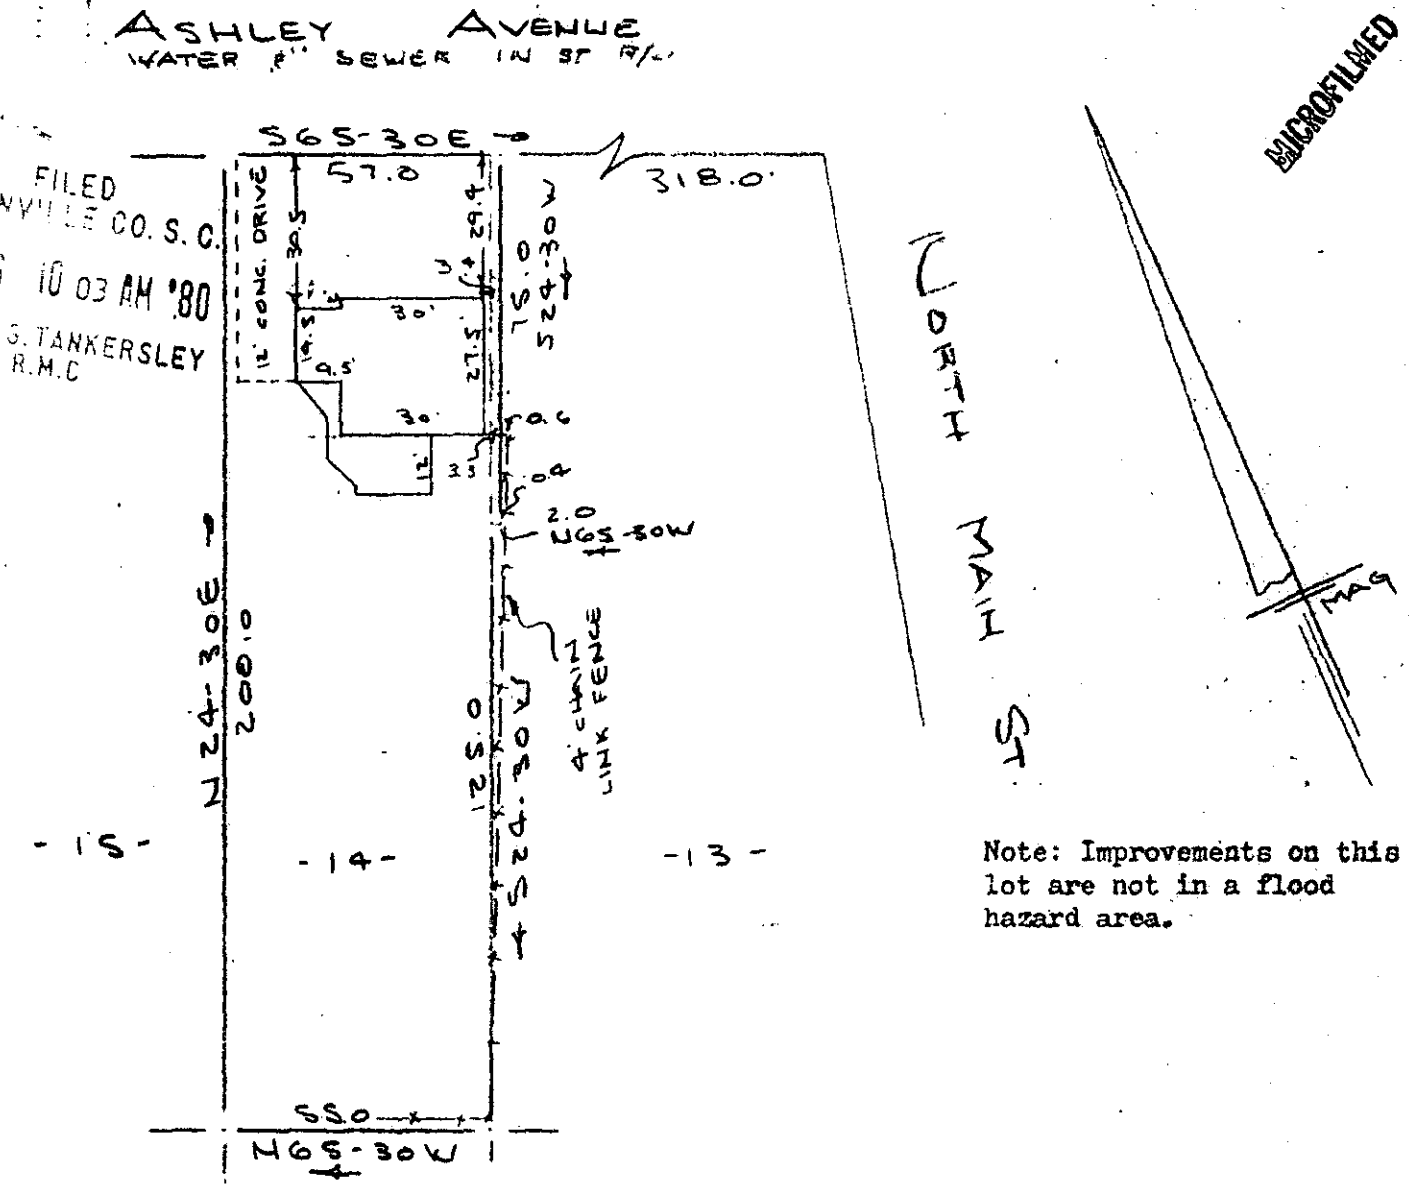


Note: Improvements on this lot are not in a flood hazard area.

PROPERTY OF

JOHN W. WORTHINGTON & FRANCES S. WORTHINGTON

GREENVILLE, S. C.

SCALE: 1" = 40'  22 MAY 1980

This is to certify that on the 22nd day of May, 1980, I surveyed the property shown on this plat, being known as lot 14 and part of lot 13 on plat of PROPERTY OF B. E. GEER and recorded in the RMC Office Greenville County, S. C., in Plat Book " H " at Page 177 and also being known as PROPERTY OF JOHN W. WORTHINGTON & FRANCES S. WORTHINGTON and recorded in Plat Book at Page ; and that the property lines, walls and buildings are as shown hereon, and that the walls and buildings located on said lot do not encroach or project on adjacent street or property, and that no adjacent walls or buildings encroach or project on said premises, and no power lines cross this property except as shown hereon.

18-B-14

34106

MAY 26 1980

R. B. Bruce

R. B. Bruce, RLS #1952

CAROLINA SURVEYING CO. 612
112 Manly St.
Greenville, S. C.