




FILED  
GREENVILLE CO. S. C.  
JUN 3 3 54 PM '80  
DONNIE S. TANKERSLEY  
R.M.C.

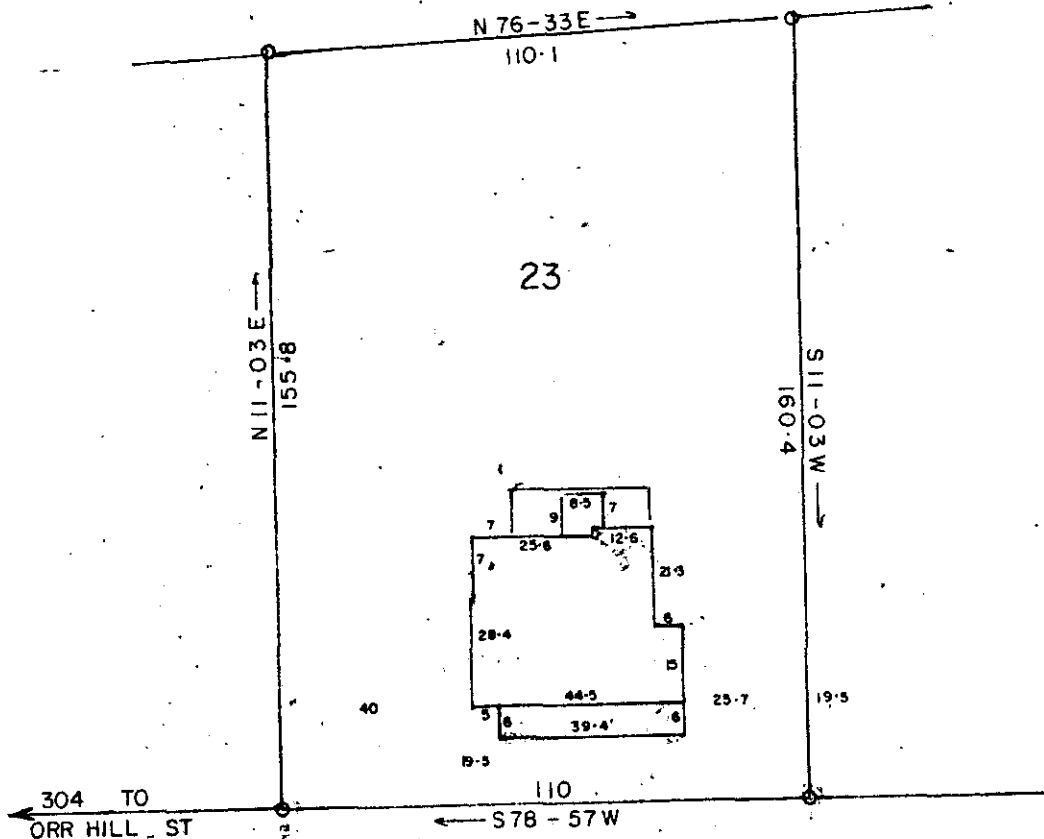

SC 86

MAIN

ST

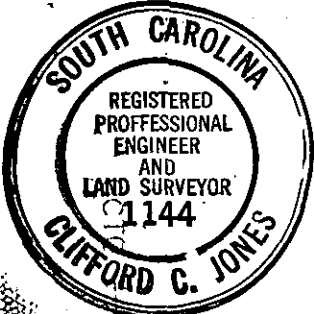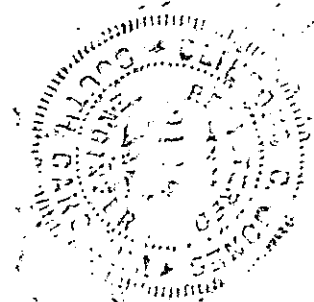

JUN 3 1980

34865

✓ 8-B-381

JUN 3 1980

NOTE. THIS LOT DOES NOT LIE IN A FLOOD PLANE.

PROPERTY OF

JO-ANN JOHNSON

ROY A. JOHNSON

GREENVILLE COUNTY, S. C.

SCALE 1"=40' MAY-28-80

to certify that on the 28 day of MAY 1980, I surveyed the property shown on this plat, being LOT 23 SEC. 3 PIEDMONT-MFG. CO, recorded in Plat Book 4 of the R.M.C. Office for Greenville County, S. C., and that the property lines, walls and buildings are as shown hereon; that the buildings located on said lot do not encroach or project on adjacent streets or property; and that no adjacent buildings or walls encroach or project on said premises, and that no utility lines cross this property.

*Clifford G. Jones*  
Reg. Engineer No. 1144 S.C.