

MICROFILMED

- ROSAMOND -

FILED GREENVILLE CO. S.C.

JUN 19 11 14 AM '80

DONNIE S. TANKERSLEY R.M.C.

S 53-10 E + 449.8

486.1


WELL HOUSE

SEPTIC TANK ON LOT

24' 26'

35' 9'

14.5'

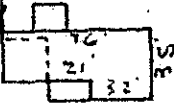

460.2' + S 35-24 W

- RUCKER -

S 18 AC.

PET LINE

1426'

507.5

+ N 55-52 W

GODFREY ROAD

ROSAMOND

N 42-11 E + 296.4

GRAVEL DRIVE

WOODRUFF ROAD

PROPERTY OF

BRADLEY R. JOHNSON & ANGELA E. JOHNSON

NEAR GREENVILLE, S.C.

SCALE: 1" = 100'

17 JUNE 1980

This is to certify that on the 17th day of June, 1980, I surveyed the property shown on this plat, being known as a 5.18 acre tract on plat of PROPERTY OF ROSAMOND ENTERPRISES INC. and recorded in the REC Office Greenville County, S. C., in Plat Book "5Y" at page 93; and that the property lines, walls and buildings are as shown hereon, and that the walls and buildings located on said lot do not encroach or project on adjacent street or property, and that no adjacent walls or buildings encroach or project on said premises, and no power lines cross this property except as shown hereon.


36229

8-B-71

R. B. Bruce, RLS #1952

JUN 19 1980

CAROLINA SURVEYING CO. 112 Kanby St, Greenville, S. C.

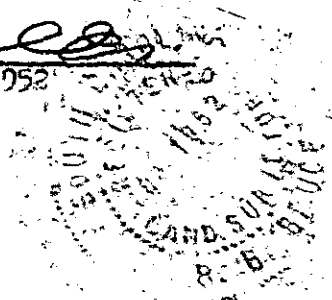

GCTD 3 JUN 19 80 1528

3.0001