MICROFILMED

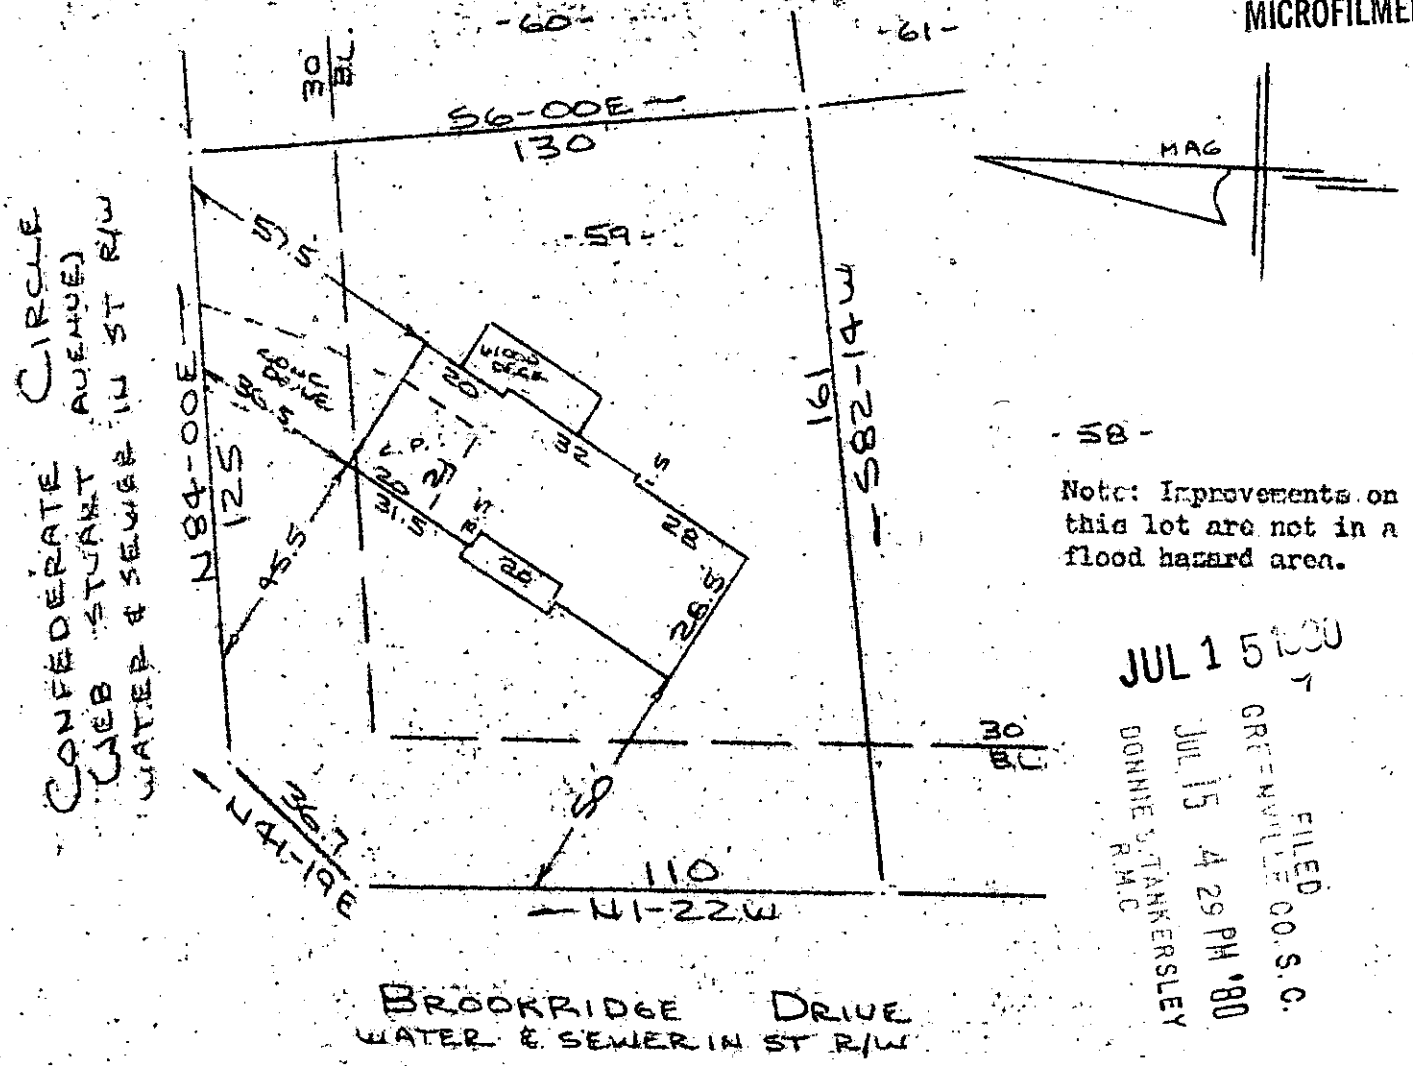

Note: Improvements on this lot are not in a flood hazard area.

JUL 15 '80

FILED
GREENVILLE CO. S.C.
JUL 15 4 29 PM '80
DONNIE S. TANKERSLEY
R.M.C.

PROPERTY OF
JOHN F. HANSLEY & LISA G. HANSLEY
NEAR GREENVILLE, S.C.
SCALE: 1"=40 10 JULY 1980

This is to certify that on the 10th day of July, 1980, I surveyed the property shown on this plat, being known as lot 59 on plat of SHEFFIELD FOREST and recorded in the RMC Office Greenville County, S. C., in Plat Book " BBB " at Page 61; and that the property lines, walls and buildings are as shown hereon, and that the walls and buildings located on said lot do not encroach or project on adjacent street or property, and that no adjacent walls or buildings encroach or project on said premises, and no power lines cross this property except as shown hereon.

8-C-36 1265

R. B. Bruce

R. B. Bruce, R.L.S. 3052

CAROLINA SURVEYING CO.
112 Manly St.
Greenville, S. C.

0628 PG 15E

300 A4

323/550