


MICROFILMED

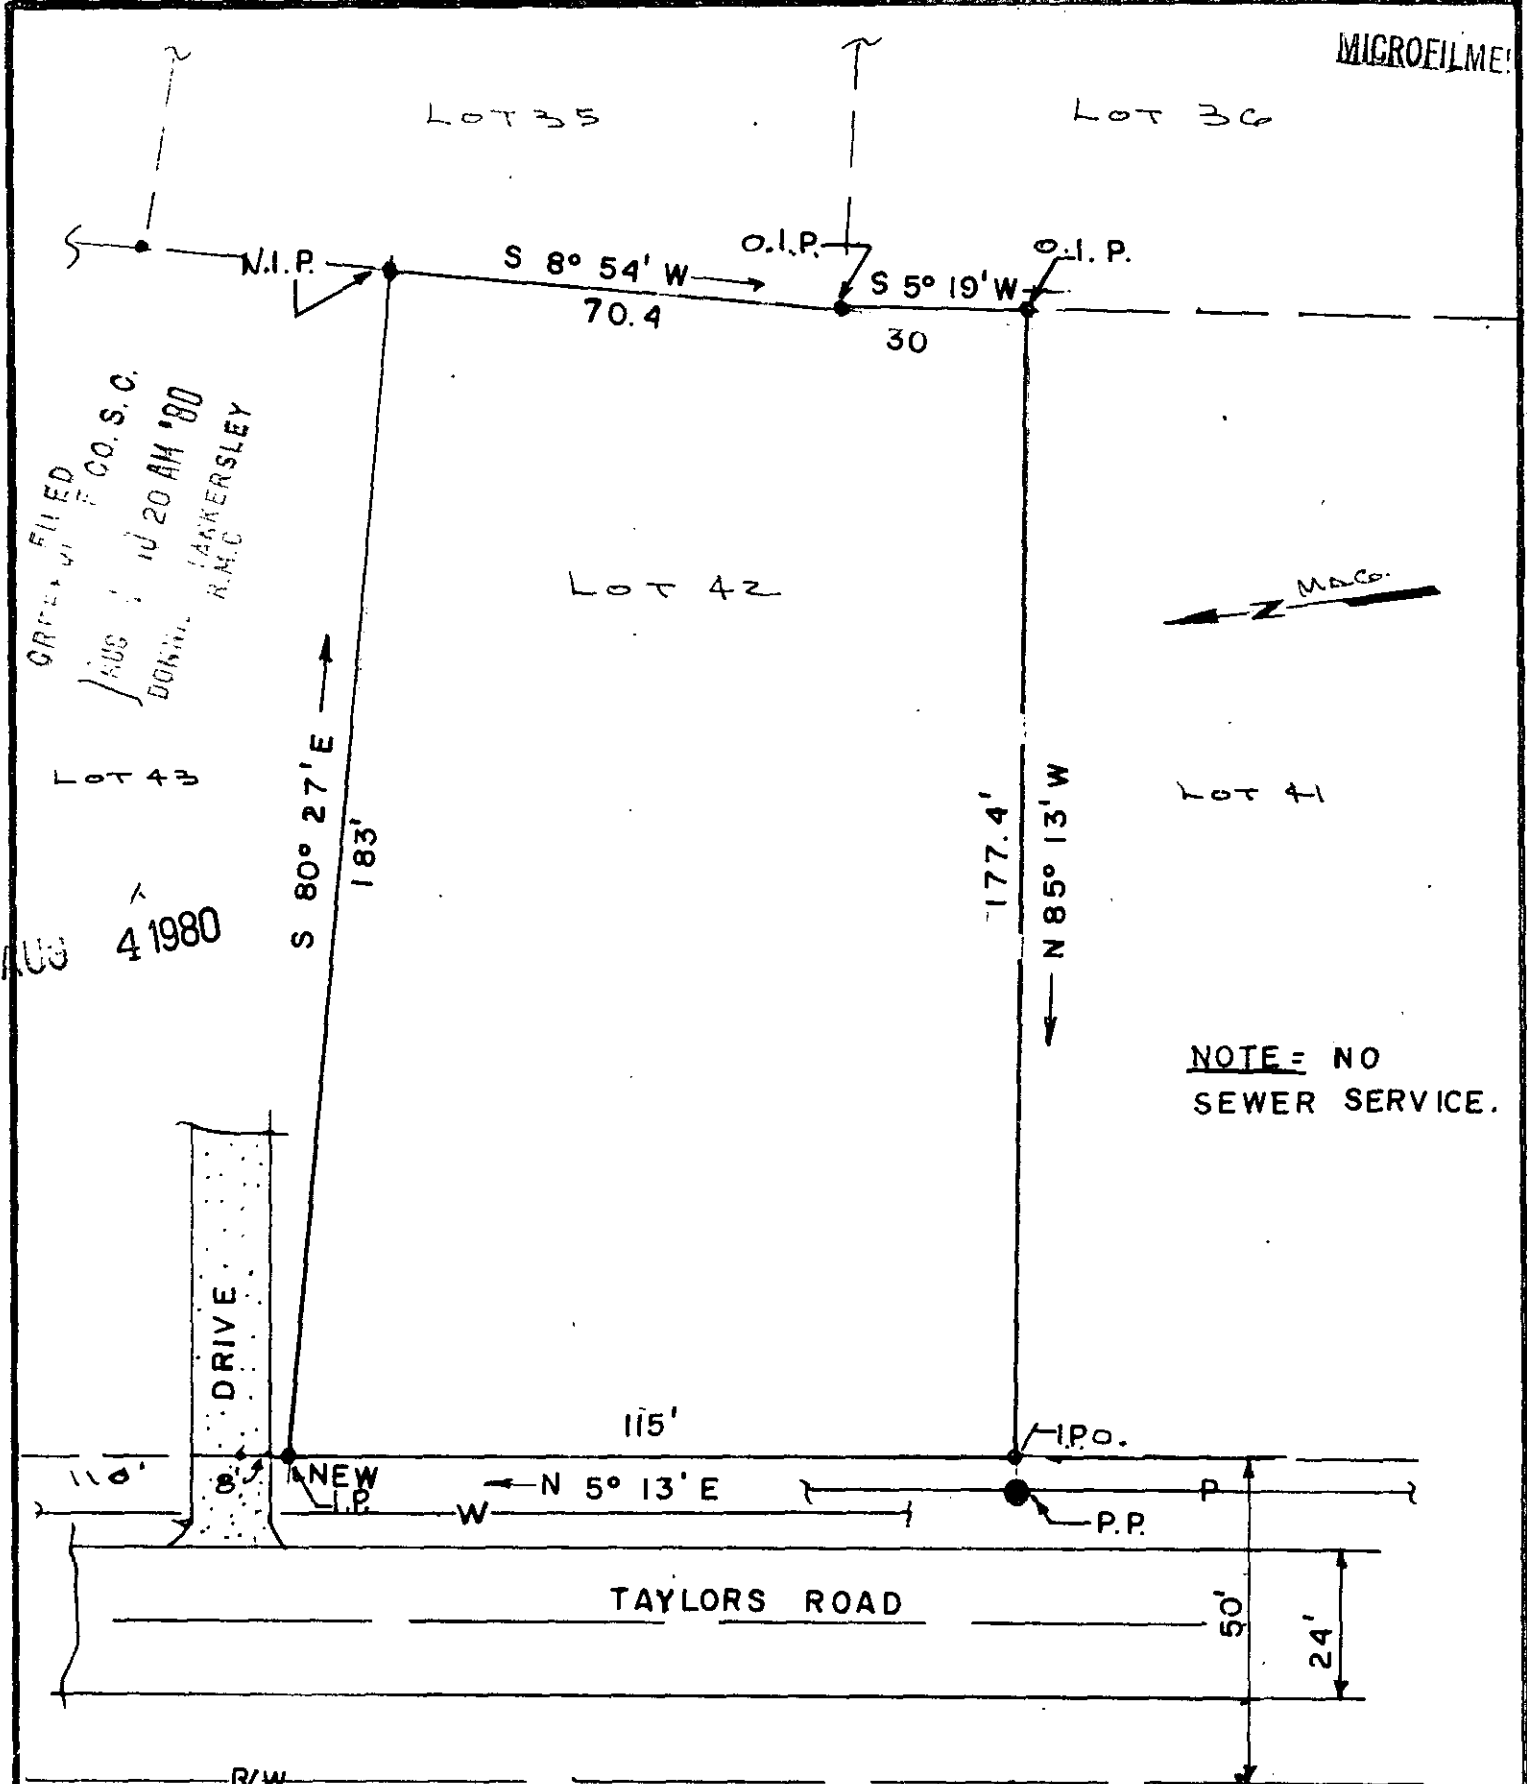


NOTE = NO SEWER SERVICE.

SECTION No. 1
LOCATION = BELMONT HEIGHTS
SUBDIVISION, GREER, SC
(GREENVILLE COUNTY)

I CERTIFY THAT THIS LOT HAS
BEEN SURVEYED, AND IS AS SHOWN, ✓
Kenneth J. Gould
S.C. REG. NO. 4035 3310

REF = PLAT BOOK RR, PG. 38.
DEED VOL. 1005, PG. 1.

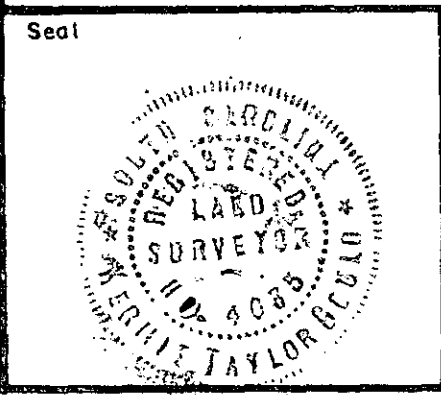

PROPERTY OF
MACELRATH AND TUCKER

GOULD & ASSOC
SURVEYORS
TAYLORS, S. C.

Drawn By K. GOULD, JR.
Checked By K. T. G.
Scale 1" = 30'
Date 7/24/80
File No.
Dwg. No.