MICROFILMED

FILED
GREENVILLE CO. S. C.
AUG 22 4 37 PM '80
DONNIE S. TANKERSLEY
R.M.C.

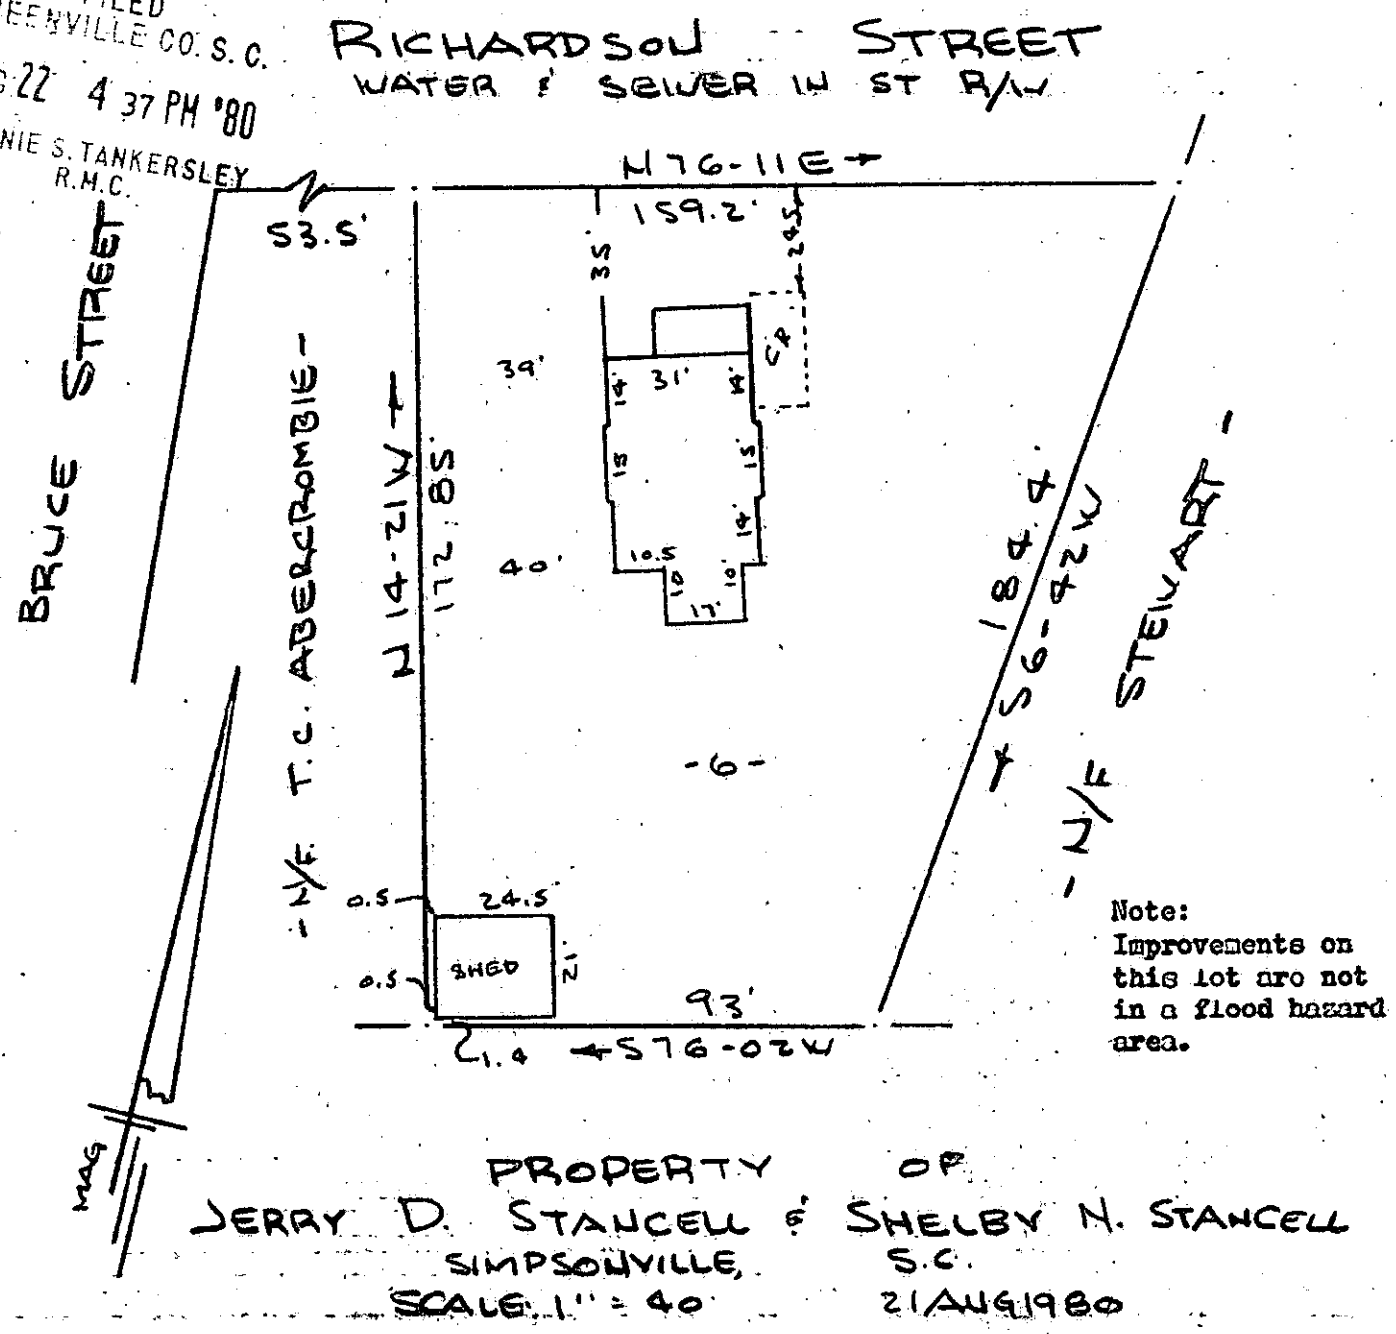

Note:
Improvements on this lot are not in a flood hazard area.

PROPERTY OF
JERRY D. STANCELL & SHELBY N. STANCELL
SIMPSONVILLE, S.C.
SCALE 1" = 40' 21 AUG 1980

This is to certify that on the 21st day of August, 1980, I surveyed the property shown on this plat, being known as lot 6 on plat of PROPERTY OF L. L. RICHARDSON and recorded in the RMC Office Greenville County, S. C., in Plat Book " MM " at Page 95; and that the property lines, walls and buildings are as shown hereon, and that the walls and buildings located on said lot do not encroach or project on adjacent street or property, and that no adjacent walls or buildings encroach or project on said premises, and no power lines cross this property except as shown hereon.

8-D-66

R. B. Bruce

R. B. Bruce, RLS #1952

5547

CAROLINA SURVEYING CO.
112 Manly St.
Greenville, S. C.

SCTC --- 1 AU22 80 478
3.00CI

228/50A 320-1-29