

REF: LOT 502 ON PLAT OF MAP  
NO. 1, SECTION II SUGAR CREEK  
RECORDED IN PLAT BOOK 7C  
PAGE 68.

NOTE: DRAINAGE AND UTILITIES  
EASEMENT 5' EACH SIDE OF  
SIDE AND REAR LOT LINES.

GCTO FILED  
GREENVILLE CO. S.C.  
AUG 26 11 13 AM '80  
DONNIE S. TANKERSLEY  
R.M.C.

PROPERTY OF  
JEFFREY R. & TRUDI A. ROUNSLEY  
NEAR GREENVILLE S.C.  
SCALE 1" = 30' AUG. 1, 1980

I certify that this is an accurate plat of a survey made by me August 1st, 1980, that the improvements located on said premises do not encroach or project on adjacent streets or property, that no easements are visible on the ground except as noted hereon, and that the structures located on said premises are not in a flood plain based on the public records of Greenville County.


8-D-80

5898

AUG 26 1980

C.O. Riddle

PLS #1347 GREENVILLE, S.C.

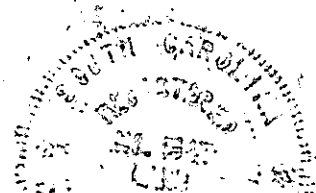

3.0001