


FILED
GREENVILLE CO. S. C.

SEP 2 1 21 PM '80

DONNIE S. TANKERSLEY
R.M.C.

Note: Improvements
on this lot are not
in a flood hazard area.

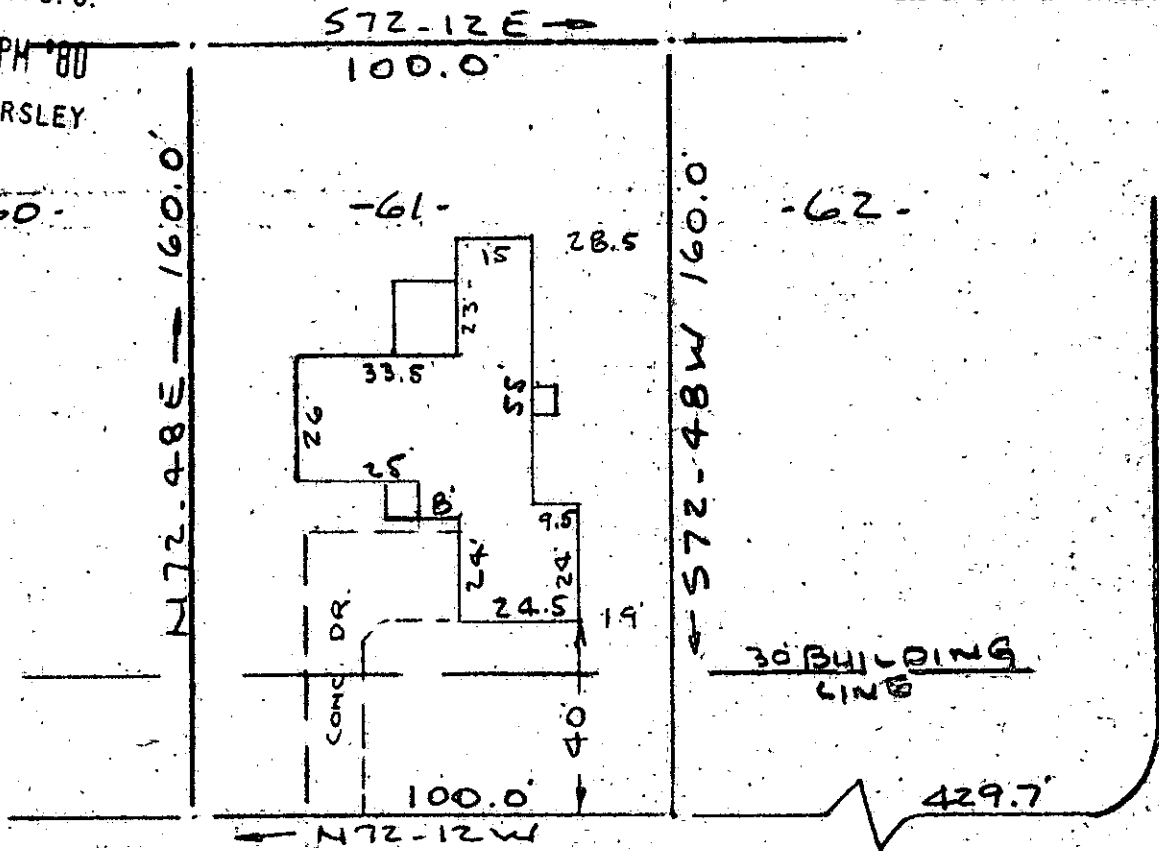

MILLER ROAD

BURNING BUSH LANE
WATER & SEWER IN ST. R/W.

PROPERTY OF
DANIEL C. DUNAT & NIDA E. DUNAT
MAULDIN, S. C.
SCALE 1" = 40' 25 AUG 1980

This is to certify that on the 25th day of August, 1980, I surveyed the property shown on this plat, being known as lot 61 on plat of SECTION 7 FORNESTER WOODS Sheet 2 of 2 and recorded in the RMC Office Greenville County, S. C., in Plat Book "5 - P" at Pages 21 & 22; and that the property lines, walls and buildings are as shown hereon, and that the walls and buildings located on said lot do not encroach or project on adjacent street or property, and that no adjacent walls or buildings encroach or project on said premises, and no power lines cross this property except as shown hereon.

SEP 2 1980

✓ 8-E-9
6784

R. B. Bruce
R. B. Bruce, R.L.S. #1952

CAROLINA SURVEYING CO.
112 Manly St.
Greenville, S. C.

