


FILED
GREENVILLE CO. S. C. 56
SEP 5 9 32 AM '80
DONNIE S. TANKERSLEY
R.M.C.

NG4-57E 5' REC. FOR UTILITIES

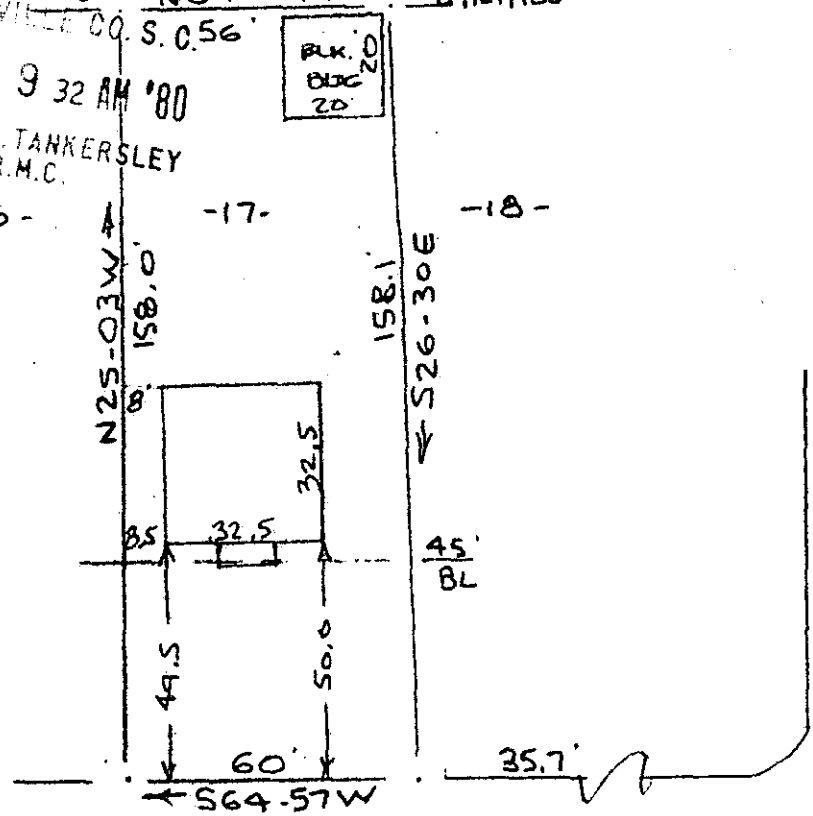

Note:
Improvements on this lot are not in a flood hazard area.

STATE PARK RD. (PARIS MTN. RD.)
WATER & SEWER IN ST. RIW

PROPERTY OF
WILLIAM C. KANEFT & JANET F. KANEFT
NEAR GREENVILLE, S. C.
SCALE: 1"=40' 2 SEPT 1980

This is to certify that on the 2nd day of September, 1980, I surveyed the property shown on this plat, being known as lot 17 on plat of NORTH SUNSET HILLS and recorded in the RMC Office Greenville County, S. C., in Plat Book "L" at Page 92 and also known as PROPERTY OF WILLIAM C. KANEFT & JANET F. KANEFT and recorded in the RMC Office Greenville County, S. C., in Plat Book at Page ; and that the property lines, walls and buildings are as shown hereon, and that the walls and buildings located on said lot do not encroach or project on adjacent street or property, and that no adjacent walls or buildings encroach or project on said premises, and no power lines cross this property except as shown hereon.

8-E-25
7313

R. B. Bruce
R. B. Bruce, RLS #1952

CAROLINA SURVEYING CO.
112 Manly St.
Greenville, S. C.

