


FILED
GREENVILLE CO. S. C.
SEP 9 4 09 PM '80
DONNIE S. TANKERSLEY
R.M.C.

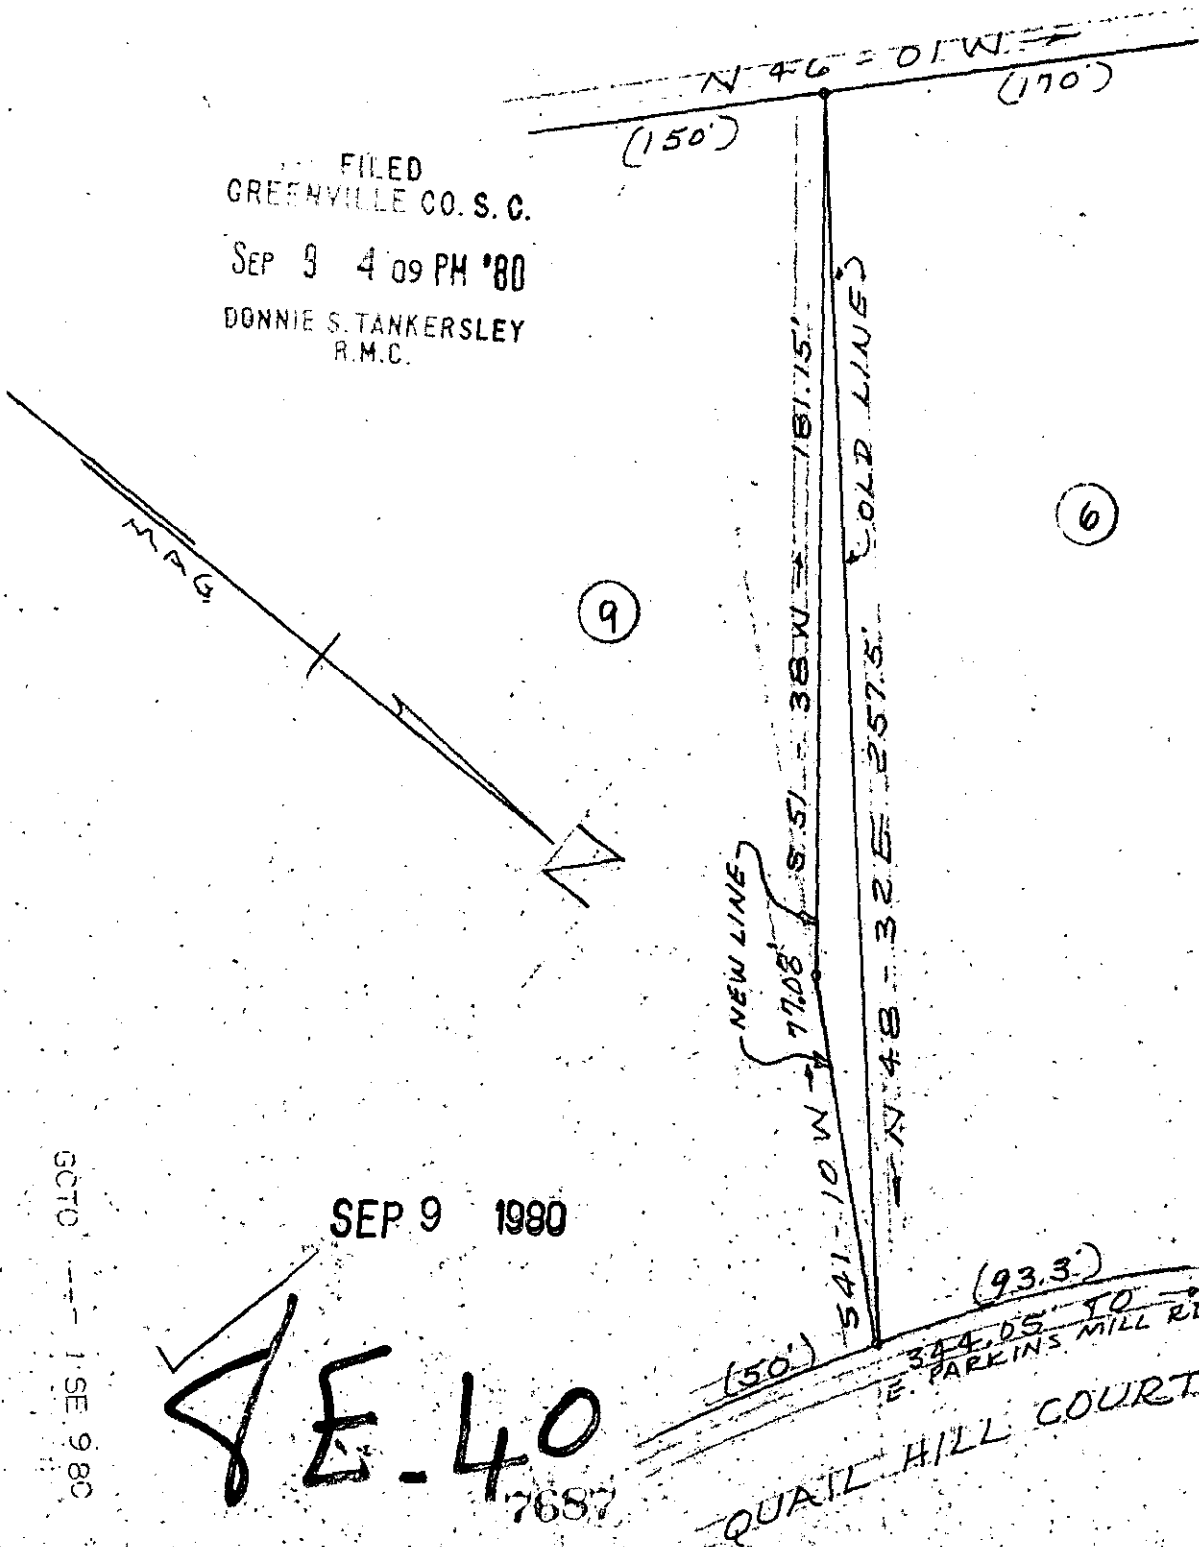

SEP 9 1980


E-40
7687

QUAIL HILL COURT
344.05 TO
E. PARKINS MILL RD.

3010
1 SE 9 80 540

3.00CT

LINE REVISION
LOTS 649 - QUAIL HILL II
GREENVILLE, S.C.
SEPT. 8, 1980 SCALE 1"=40'

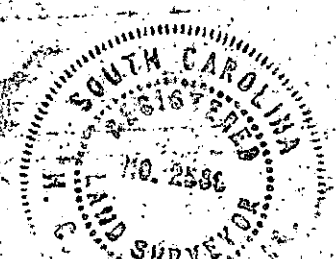

SURVEY BY: CLARKSON SURVEYING - A.C. Clarkson, Jr. No. 2589