AF 10505

MICROFILMED

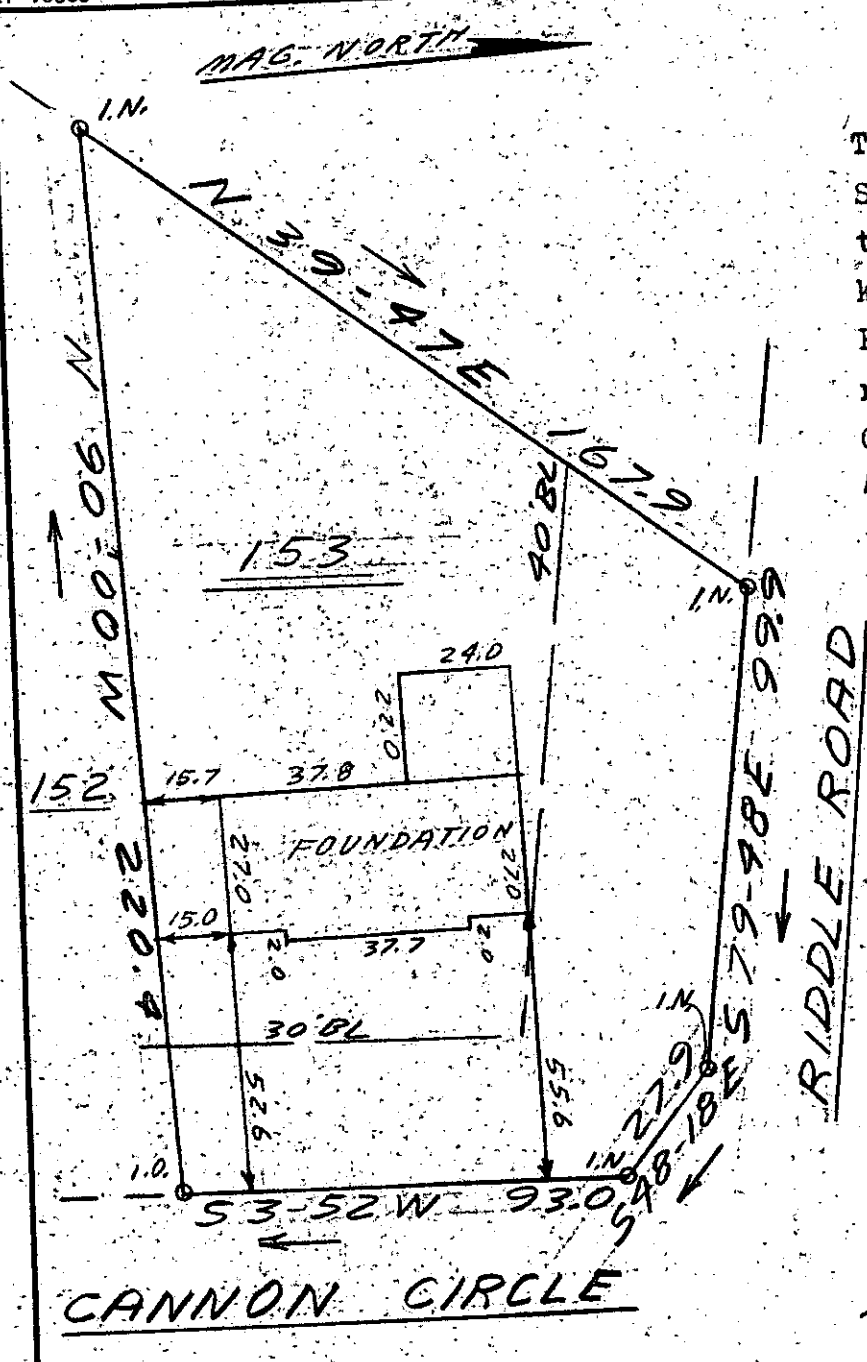

This is to certify that on September 2, 1980, I surveyed the property shown on this plat, known as Lot 153 on plat of Pine Brook Forest Sec. 2, recorded in the RMC Office of Greenville County in Plat Book 4X on page 49, and that the property lines, walls and buildings are as shown hereon; that the building located on said lot does not encroach or project on adjacent streets or property, and that no adjacent walls or buildings encroach or project on said premises, and that no utility lines cross this property except as shown hereon. This property is not located in a designated flood hazard area.

5' drainage and utility easement along each side and rear lot lines.

James R. Freeland RLS & PE 4781

8510

SEP 16 1980

8-E-71

FILED
GREENVILLE CO. S.C.
SEP 16 4 29 PM '80
DONNIE S. TANKERSLEY
R.M.C.

SOUTH CAROLINA
REGISTERED
LAND SURVEYOR
NO. 4781
JAMES RALPH FREELAND

SEAL

STATE OF SOUTH CAROLINA
GREENVILLE COUNTY

PINE BROOK FOREST
SECT. 2 - LOT 153
PROPERTY OF
JOHNNY F. LANFORD

FREELAND & ASSOCIATES
Engineers • Land Surveyors
GREENVILLE, S.C.

SURVEY	D.H.
DRAWN	J.R.F.
CHECK	MKC
SCALE	1" = 4
DATE	9-2-80
DWG. NO.	80-5596

5528 P-165 3.00 A4