

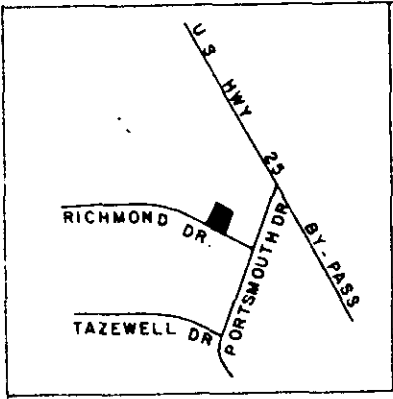


Note: References -
 D.B. 1112, pg. 21
 P.B. JJJ, pg. 81

MICROFILMED

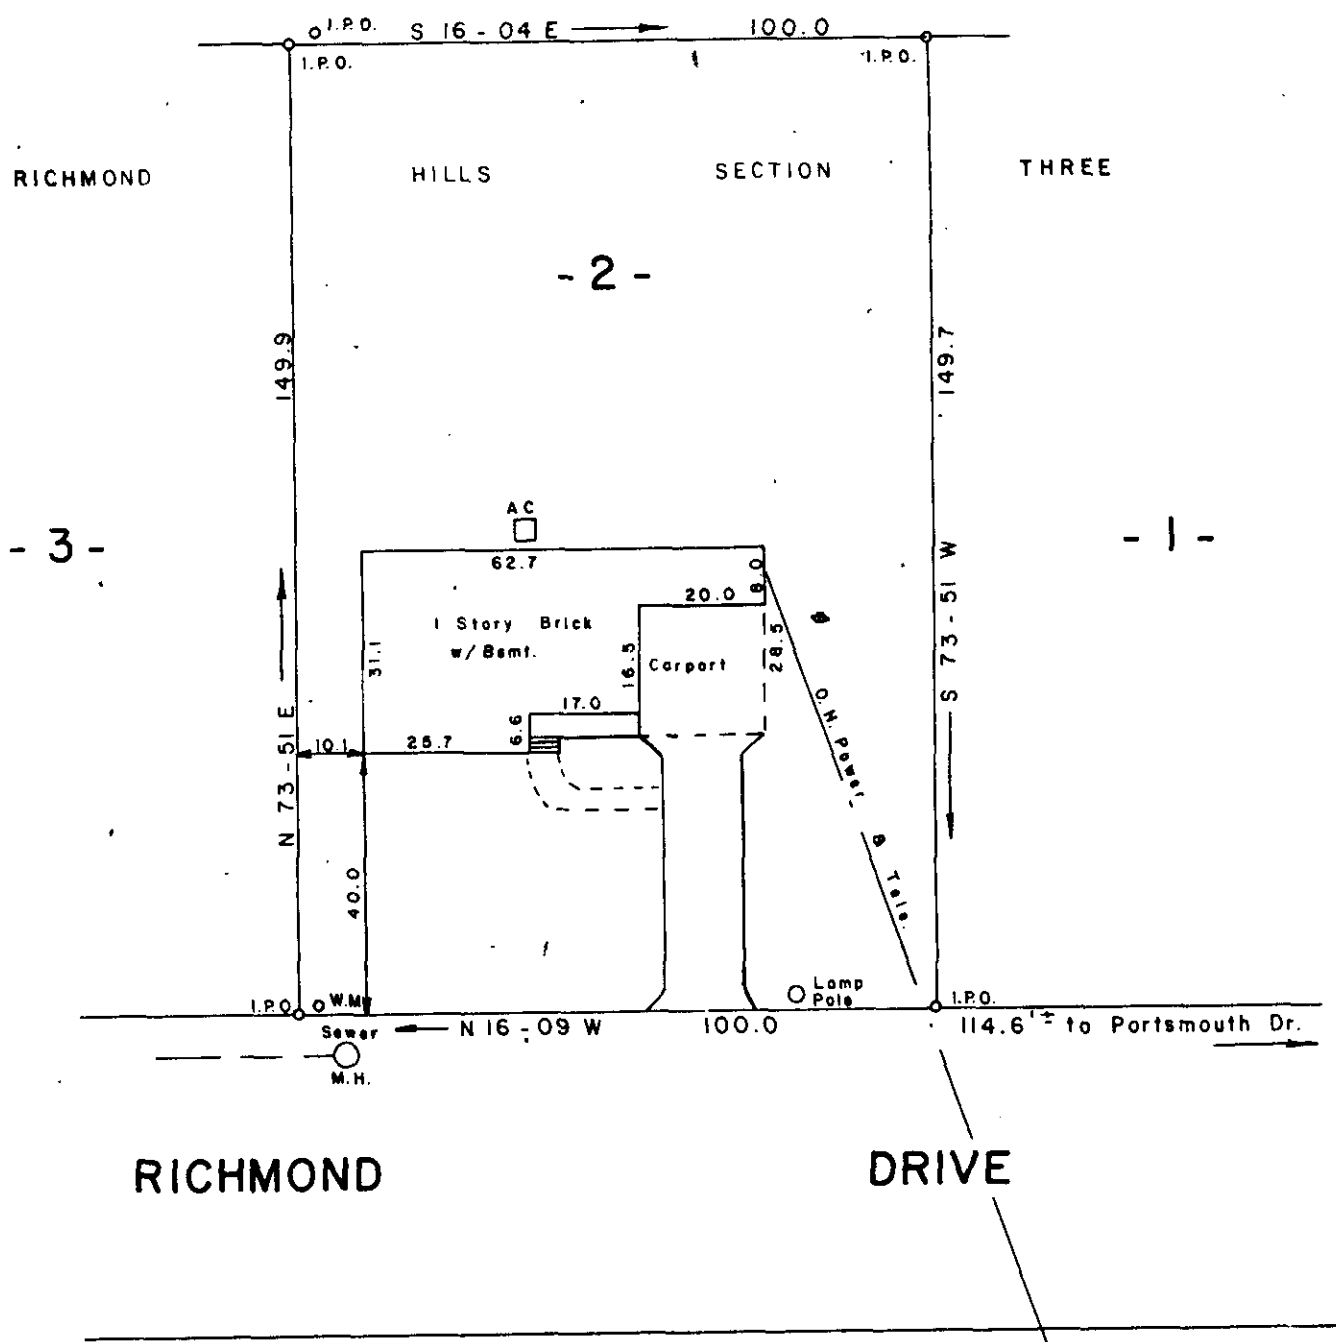

Location Map
 N.T.S.

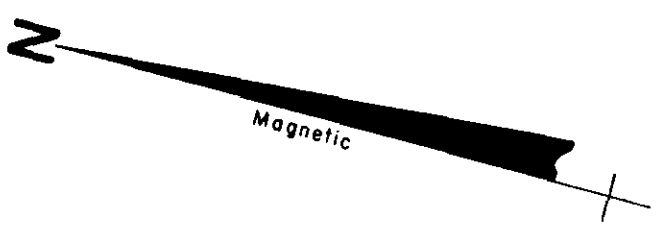

SURVEY FOR

RUDY B. JONES
DORIS N. JONES

GREENVILLE COUNTY
 SOUTH CAROLINA
 SEPT. 23, 1980

FILED
 GREENVILLE CO. S. C.
 SEP 26 3 54 PM '80
 DONNIE S. TANKERSLEY
 R.M.C.

SEP 26 1980

9782

SEP 26 1980

To The Best Of My Knowledge This Structure Is Not In An Established Flood Zone.

I Hereby Certify That The Measurements As Shown Above Are Correct And There Are No Encroachments Or Projections Other Than Shown.

Jeffery M. Plumblee

8-F-21

JEFFERY M. PLUMBLEE
 REGISTERED LAND SURVEYOR
 # 7881
 P. O. BOX 788
 TRAVELERS REST, S. C. 29690 (803) 834-4426

