



5-0001
S.E. 25 RC
538
5-0001
15
TRAVELERS REST, S.C.

FILED
GREENVILLE CO. S.C.
SEP 30 9 21 AM '80
DONNIE S. TANKERSLEY
R.M.C.

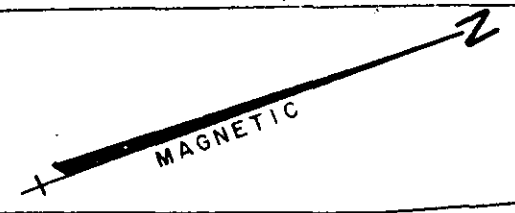

HIGHWAY # 25 BY-PASS

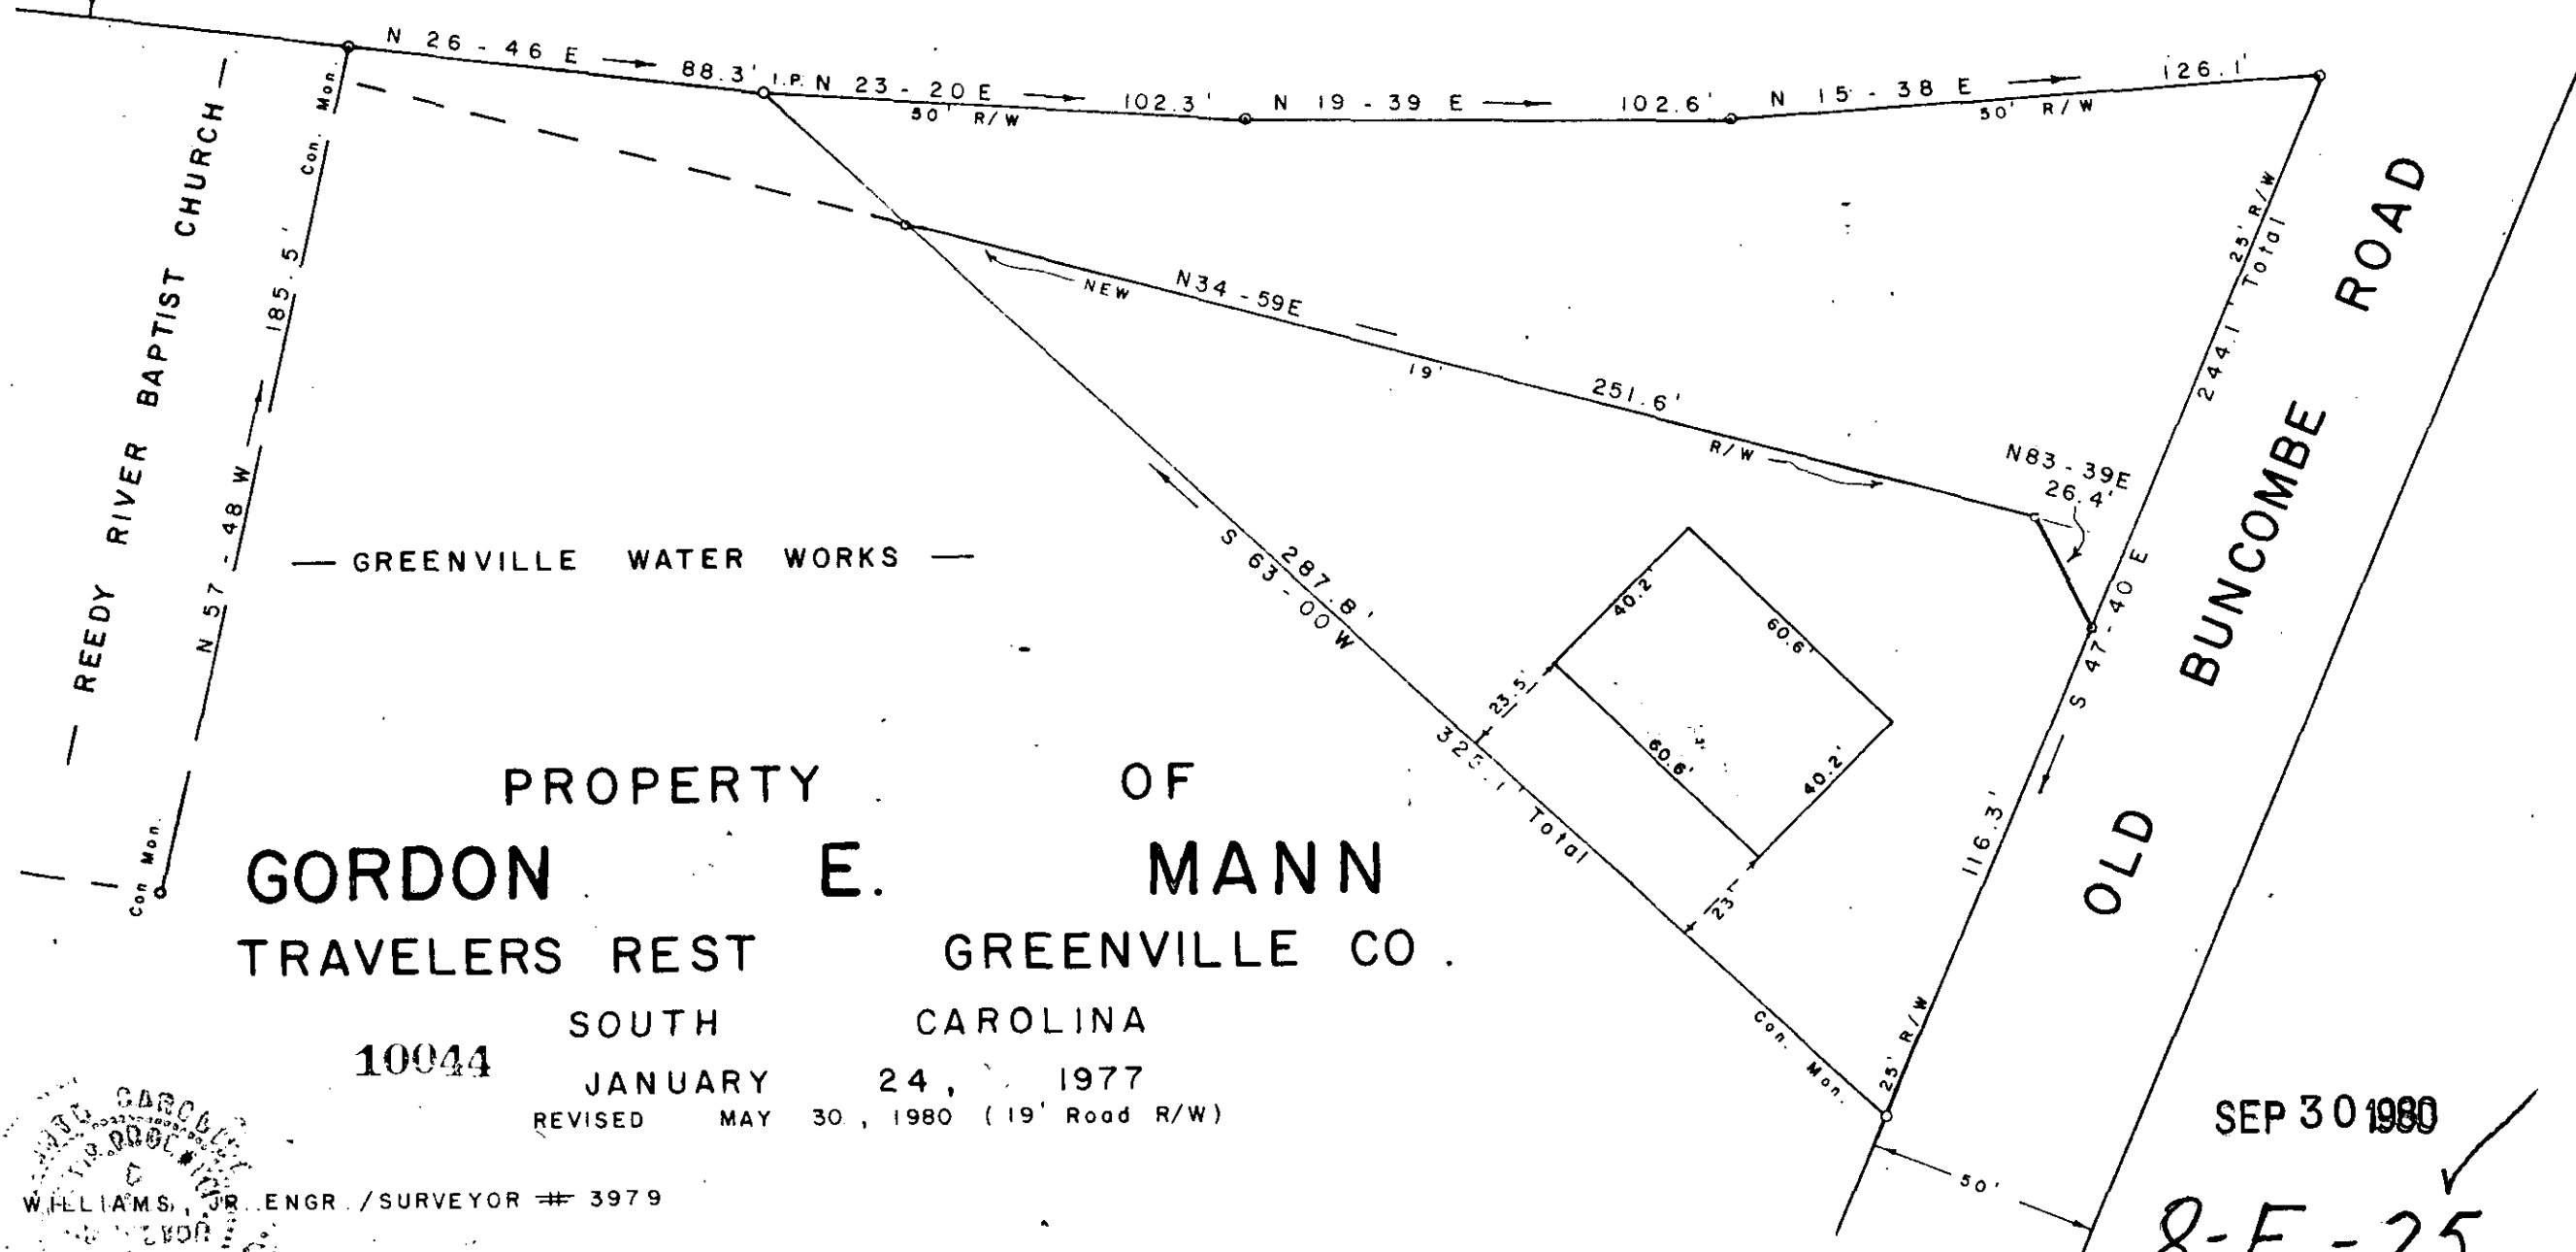

PROPERTY OF
GORDON E. MANN
TRAVELERS REST GREENVILLE CO.
SOUTH CAROLINA
10044

JANUARY 24, 1977
REVISED MAY 30, 1980 (19' Road R/W)

W. R. WILLIAMS, JR. ENGR. / SURVEYOR # 3979

SOUTH MAIN STREET

OLD BUNCOMBE ROAD

THIS PLAT IS NOT A SUBDIVISION AS DEFINED BY THE GREENVILLE COUNTY SUBDIVISION REGULATIONS.
9/30/80
Stephen W. Jarney
Chairman, Secretary, or Director of Planning,
Greenville County Planning Commission

SEP 30 1980
8-F-25