


MICROFILMED

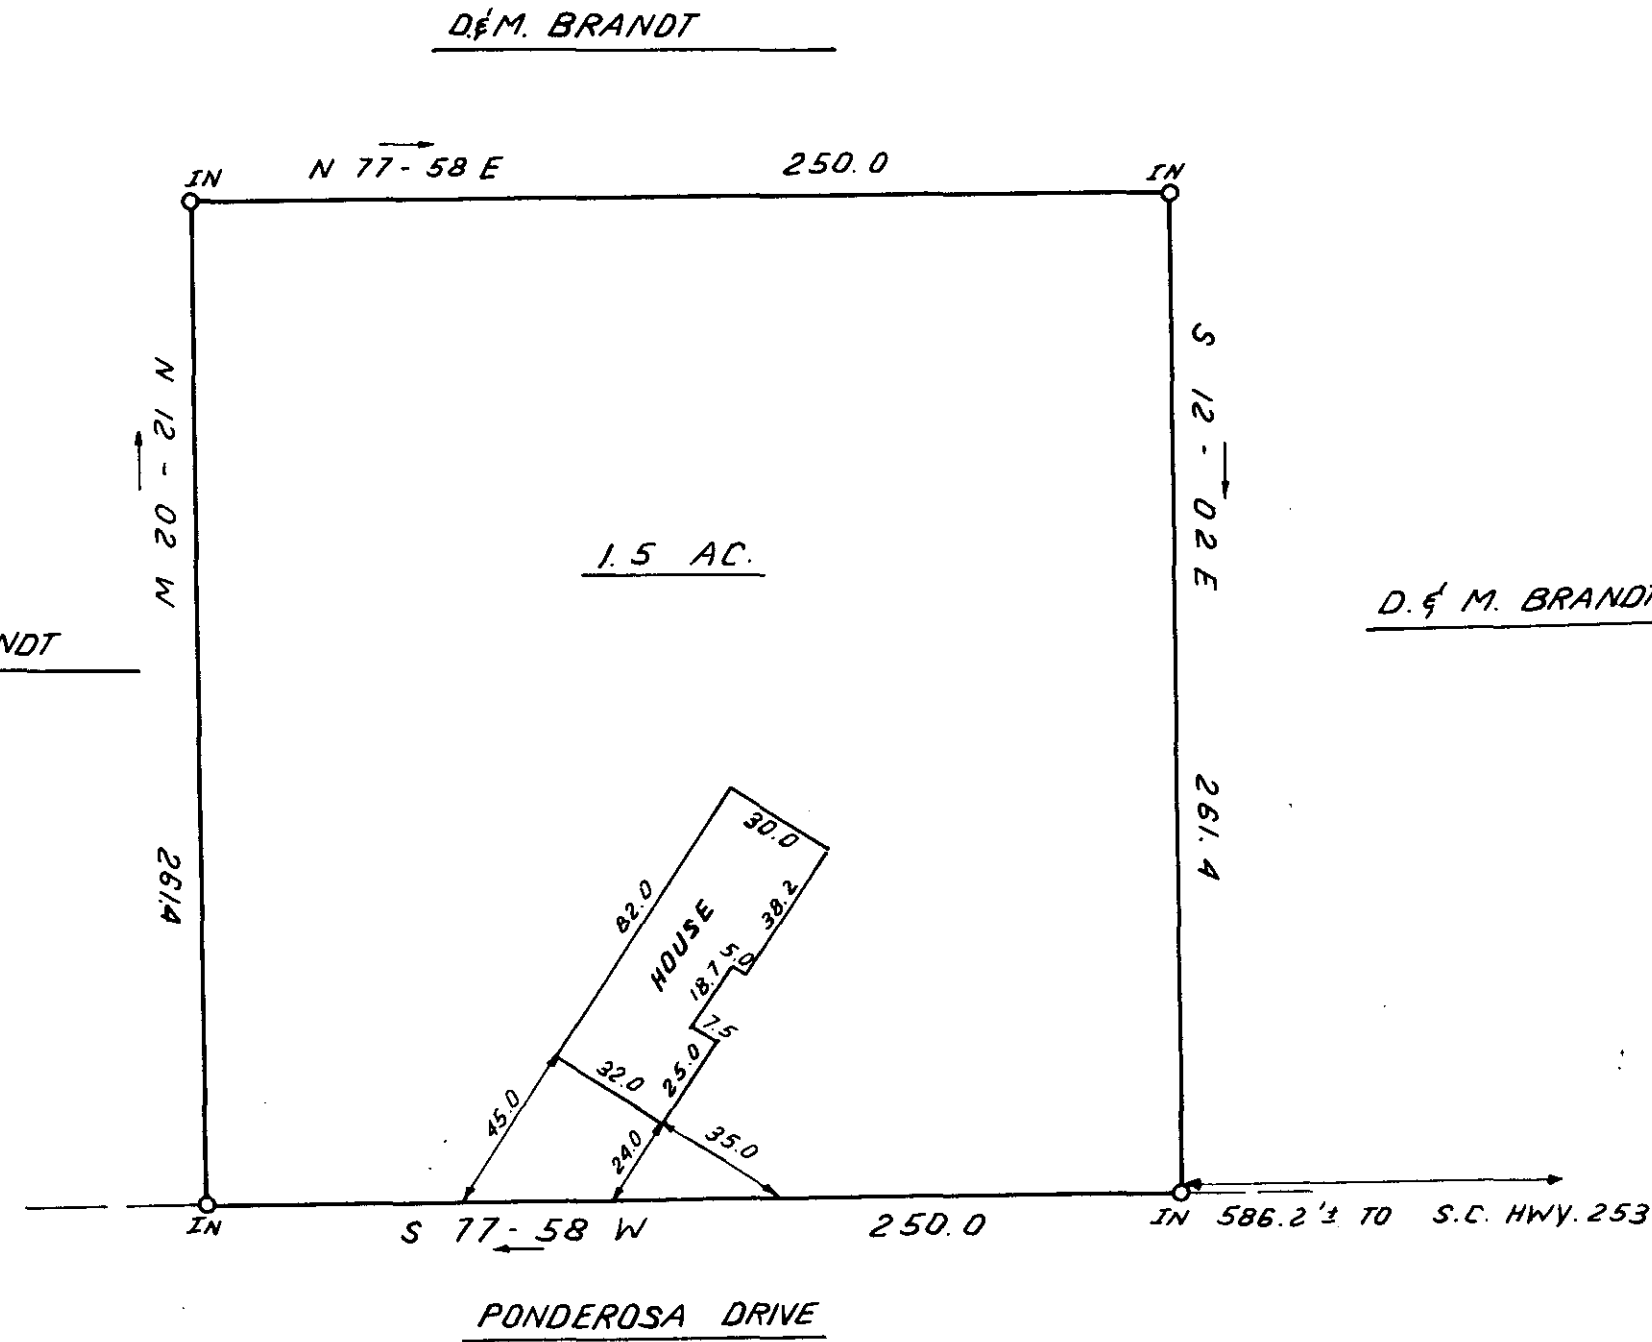


FILED
 GREENVILLE CO. S.C.
 OCT 13 3 20 PM '80
 DONNIE S. JANKERSLEY
 R.M.C.

OCT 13 1980

8-F-37 ✓

I hereby certify that the ratio of precision of the field survey is 1/5000 as shown hereon and the area was determined by DMD Method.

James R. Freeland
 James R. Freeland RLS & PE 4781

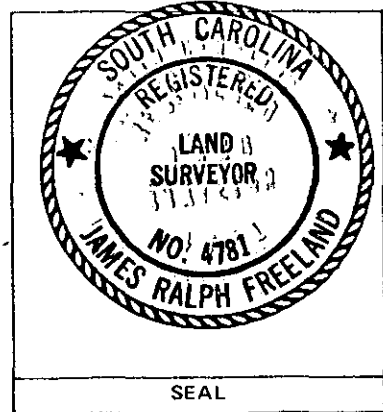

STATE OF SOUTH CAROLINA
 GREENVILLE COUNTY

PROPERTY OF
DONALD E. BRANDT
MARY E. BRANDT

FREELAND & ASSOCIATES Engineers • Land Surveyors	
GREENVILLE, S.C.	
SURVEY	L.T.
DRAWN	B.R.
CHECK	M.C.
SCALE	1" = 50'
DATE	OCT. 10, 1980
DWG. NO.	5795