


MICROFILMED

FILED  
GREENVILLE CO. S.C.  
OCT 20 3 57 PM '80  
DONNIE S. TANKERSLEY  
R.M.C.

SURVEY FOR  
SPINX OIL CO. INC.  
NEAR GREENVILLE, S.C.  
SCALE: 1" = 20' 14 OCT 1980

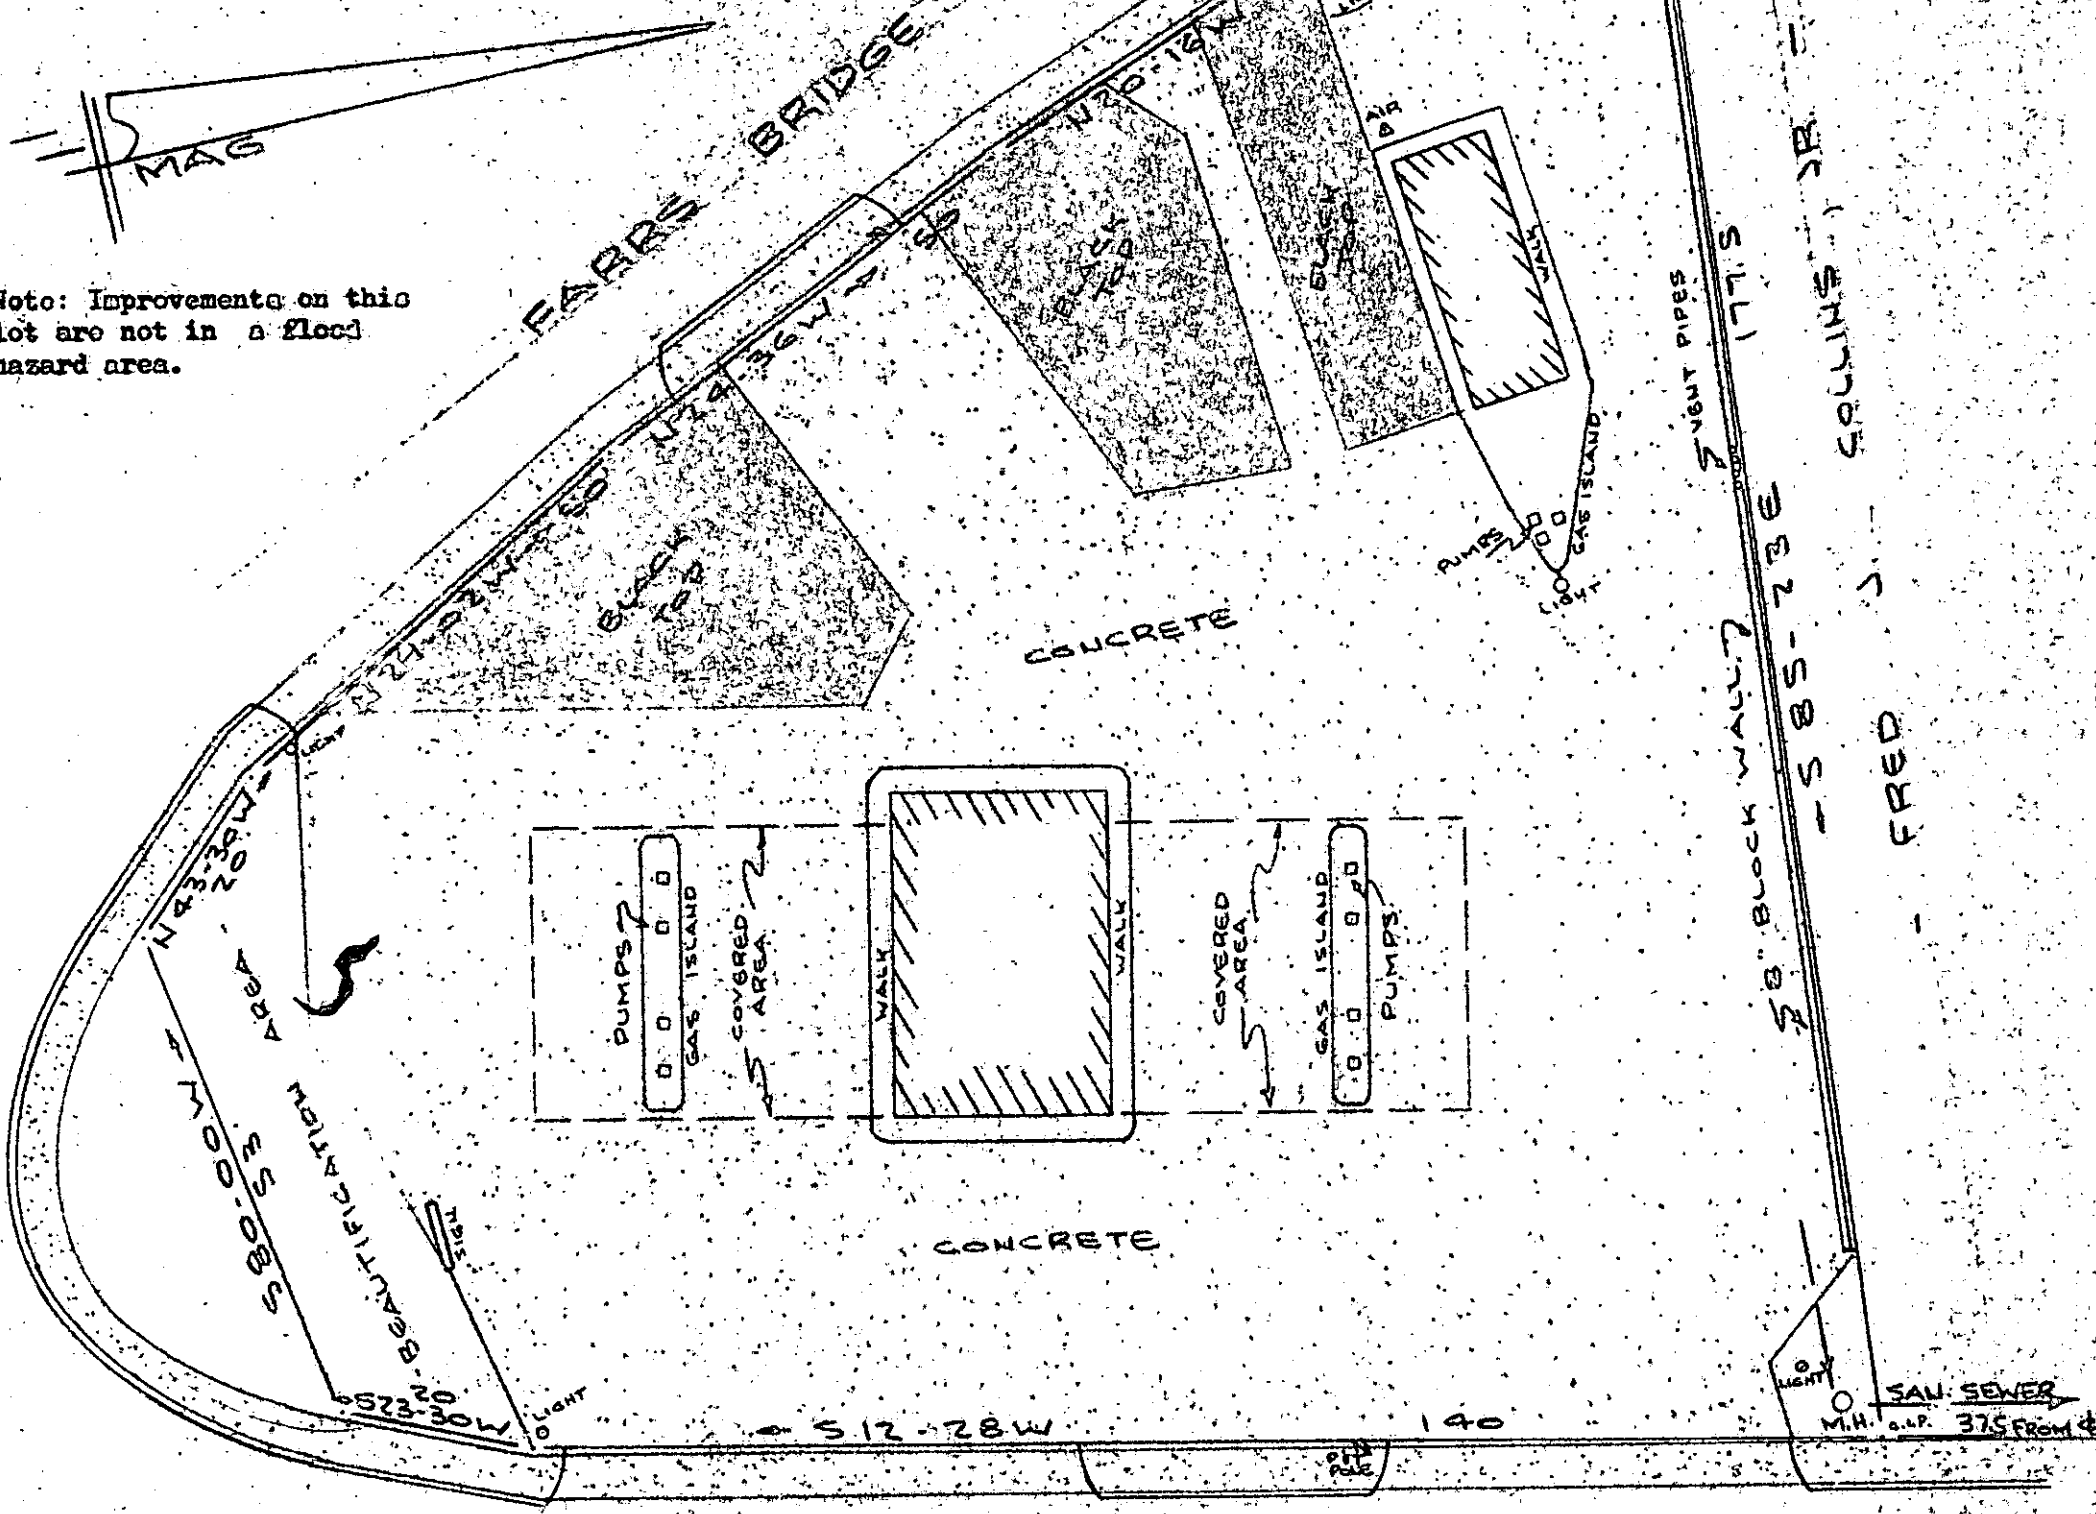

Note: Improvements on this lot are not in a flood hazard area.

This is to certify that on the 14th day of October, 1980, I surveyed the property shown on this plat, being known as SURVEY FOR SPINX OIL CO., INC. and recorded in the RMC Office Greenville County, S. C., in Plat Book "2 Q" at Page 2; and that the property lines, walls and buildings are as shown hereon, and that the walls and buildings located on said lot do not encroach or project on adjacent street or property, and that no adjacent walls or buildings encroach or project on said premises, and no power lines cross this property except as shown hereon.


OCT 20 1980

8-F-46

12426

*R. B. Bruce*  
R. B. Bruce, RLS #1953

CAROLINA SURVEYING CO.  
112 Mainly St.  
Greenville, S. C.

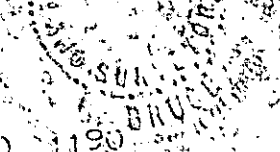

5.0001

212/10 230/23

BS 2-1-21.1