


FILED  
GREENVILLE CO. S. C.

OCT 1 10 24 AM '80

DORRIS STANKERSLEY  
R.M.C.

MICROFILM

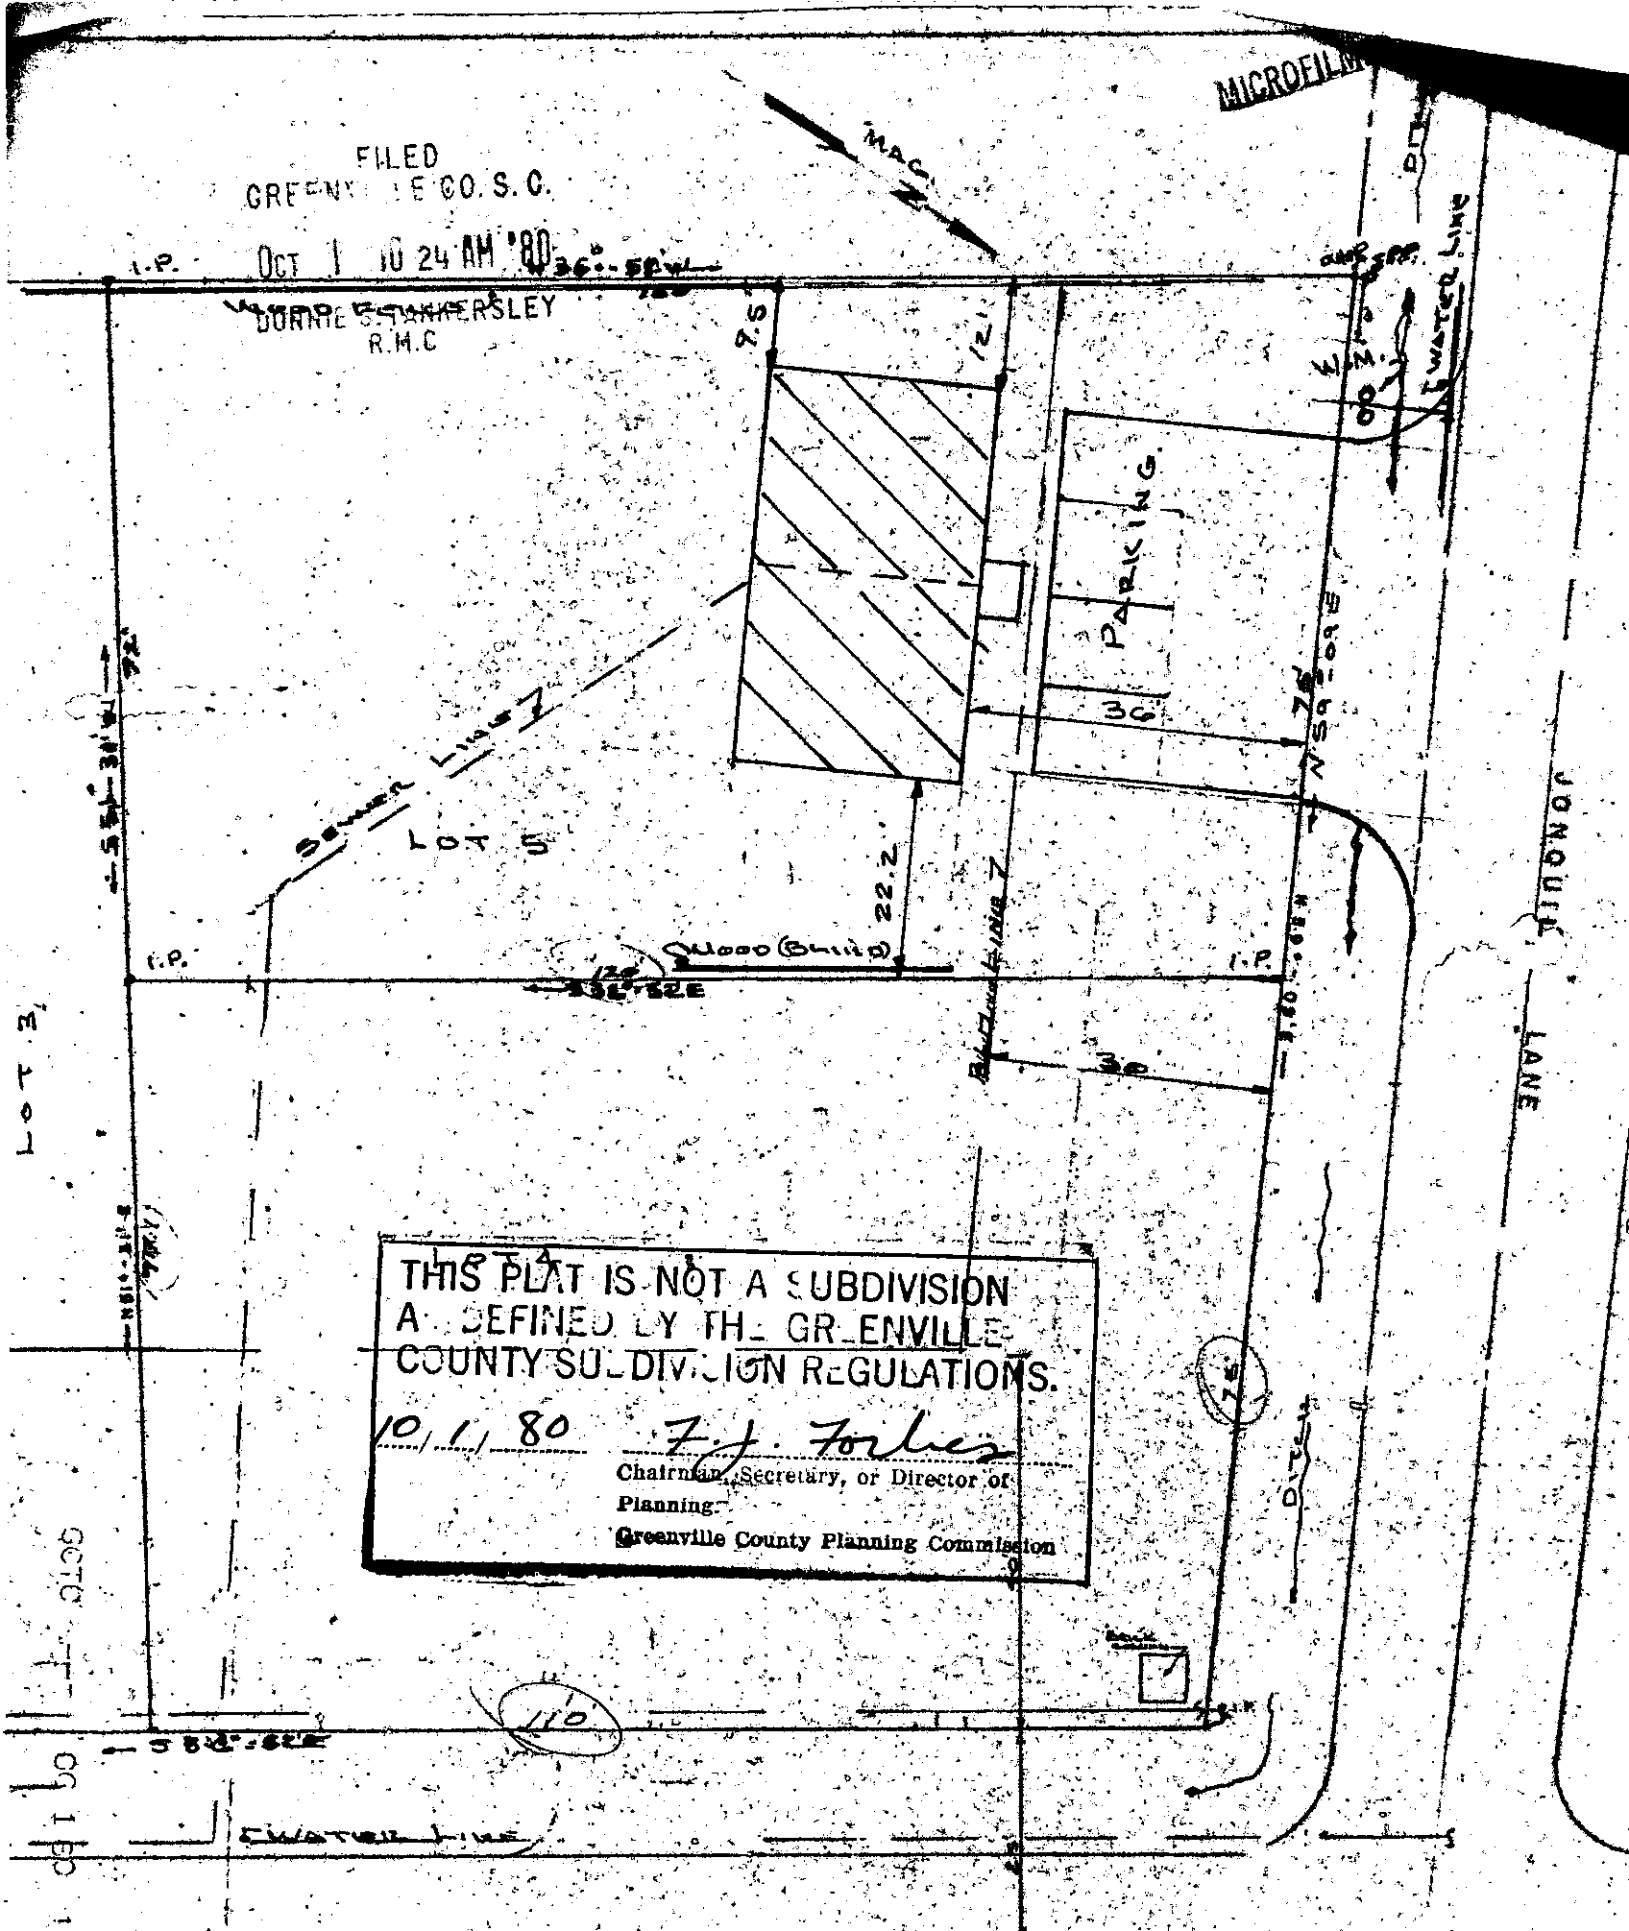

THIS PLAT IS NOT A SUBDIVISION  
 AS DEFINED BY THE GREENVILLE  
 COUNTY SUBDIVISION REGULATIONS.  
 10/1/80 *F.J. Forbes*  
 Chairman, Secretary, or Director of  
 Planning  
 Greenville County Planning Commission

8-G-32

10328 OCT 1 1980

500' To U.S. 2

NOT IN A FLOOD PLAIN &  
NO ENCROACHMENTS EXCEPT AS  
SHOWN.

DUPLEX LOCATION AS  
SHOWN ABOVE, 9-26-80

PROPERTY

OF

JOHN J. SR. & CAROL STUBBLEFIELD

CHICK SPRINGS TOWNSHIP  
GREENVILLE COUNTY  
TAYLOR, S.C.



1" = 20'