

LOT 33

PART LOT 34

PART LOT 34


FILED
 GREENVILLE CO. S.C.
 OCT 2 10 07 AM '80
 BONNIE S. TANKERSLEY
 R.M.C.

This is to certify that on September 30, 1980, I surveyed the property shown on this plat, known as Pt. Lot 34 on plat of Property of J. Rowley Yown, recorded in the RMC Office of Greenville County in Plat Book H on page 51, and that the property lines, walls and buildings are as shown hereon; that the building located on said lot does not encroach or project on adjacent streets or property, and that no adjacent walls or buildings encroach or project on said premises, and that no utility lines cross this property except as shown hereon. This property is not located in a designated flood hazard area.

James R. Freeland
 James R. Freeland RLS & PE 4781

OCT 2 1980

8-G-41 ✓ 10501

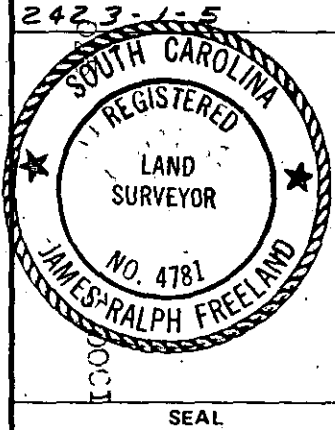

STATE OF SOUTH CAROLINA
 GREENVILLE COUNTY
 J. ROWLEY YOWN PROPERTY
 PART LOT 34
 PROPERTY OF
 ROGER B. CLINKSCALES

FREELAND & ASSOCIATES
 Engineers • Land Surveyors
 GREENVILLE, S.C.
 SURVEY LT
 DRAWN MC
 CHECK MC
 SCALE 1" = 30'
 DATE 9-30-80
 DWG. NO. 80-5724

3 OCT 2 80

2423-1-5

SEAL