

This is to certify that on October 22, 1980, I surveyed the property shown on this plat, known as Pt. Lots 52 & 53 on plat of Homestead Acres Plat 1, recorded in the RMC Office of Greenville County in plat book RR on page 35, and that the property lines, walls and buildings are as shown hereon; that the building located on said lot does not encroach or project on adjacent streets or property, and that no adjacent walls or buildings encroach or project on said premises, and that no utility lines cross this property except as shown hereon. This property is not located in a designated flood hazard area.

*James R. Freeland*  
James R. Freeland RLS & PE

12842

8-A-10  
FILED  
OCT 23 10 38 AM '80  
R.M.C. STANKESELEY


P16.1-1-323

OCT 23 1980

STATE OF SOUTH CAROLINA  
GREENVILLE COUNTY

FREELAND & ASSOCIATES  
Engineers • Land Surveyors

GREENVILLE, S.C.

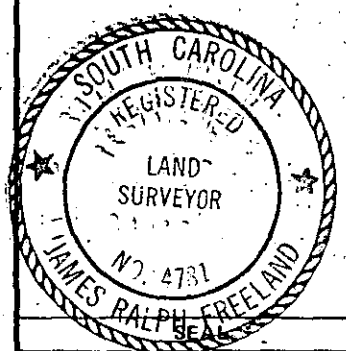

HOMESTEAD ACRES  
PLAT 1 - PART LOTS 52 & 53  
PROPERTY OF  
ALVIN DIGGS JR.  
SUSAN B. DIGGS

SURVEY	RKP
DRAWN	MLC
CHECK	MLC
SCALE	1" = 30'
DATE	10-21-80
DWG. NO.	80-5848