


FILED
GREENVILLE CO. S. C.
Nov 4 9 29 AM '80
DONNIE S. TANKERSLEY
R.M.C.


MICROFILMED

16

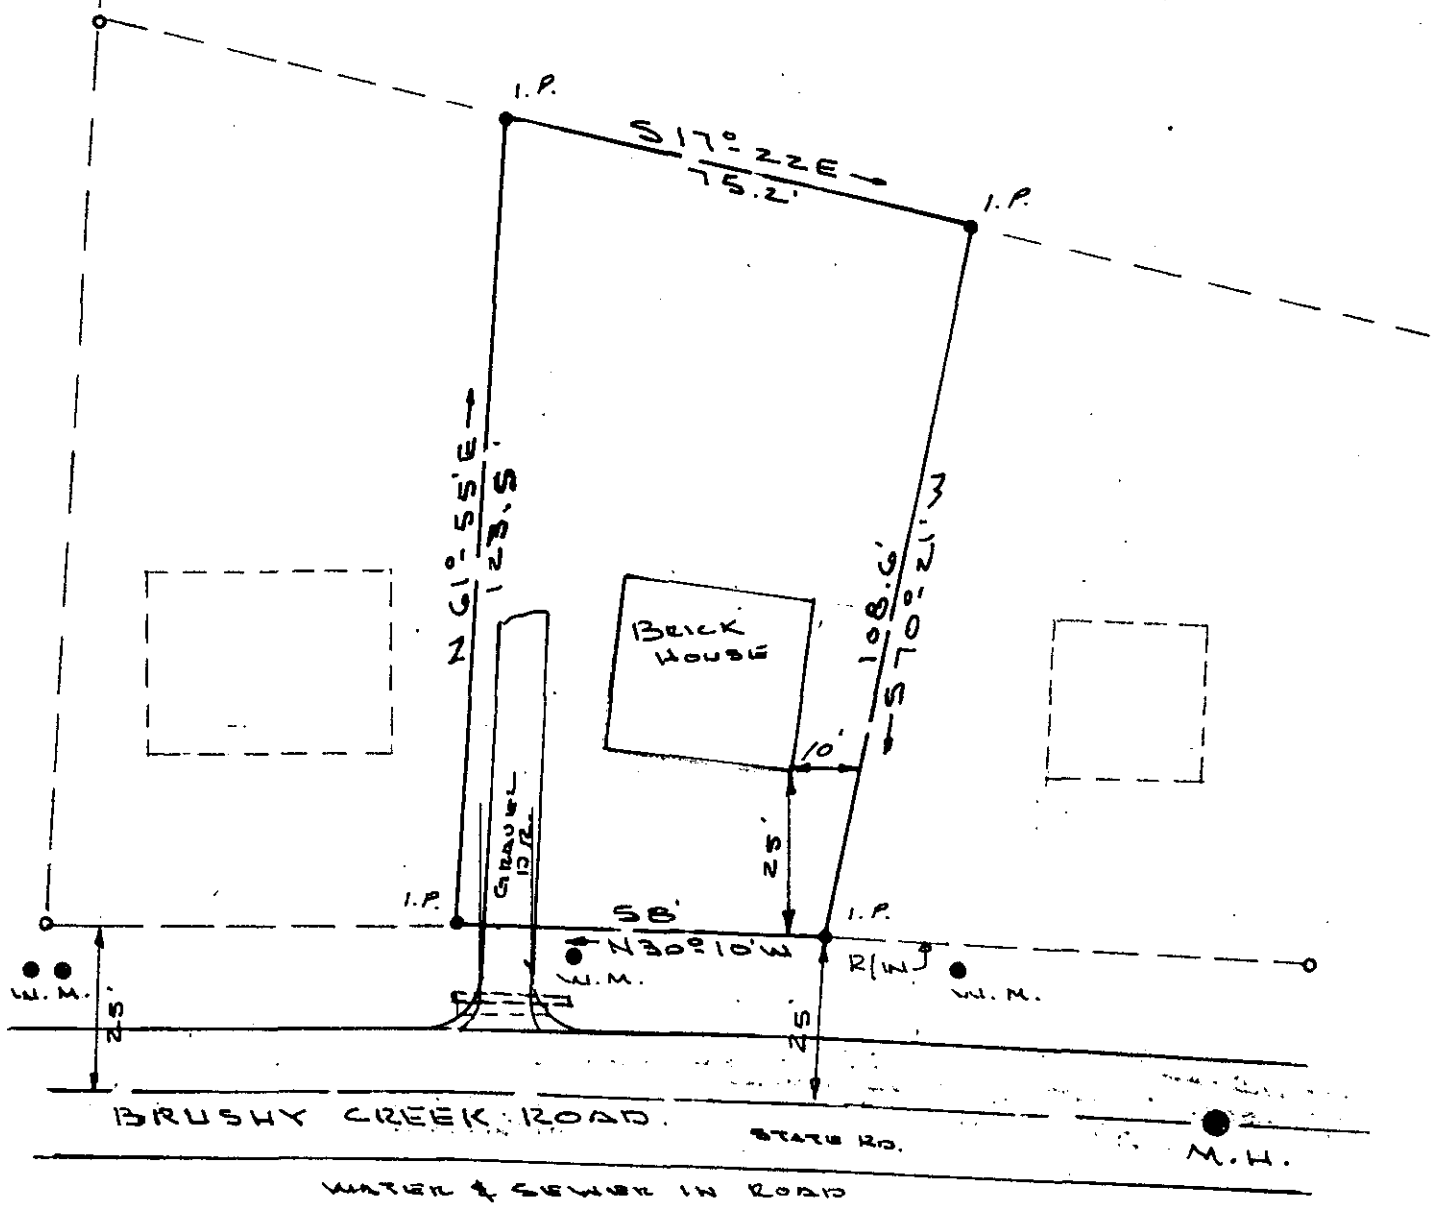

8-H-46 14019

NOV 4 1980

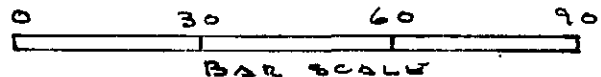

REF. DEED BK. 396 PG. 51
PLT. BK "L" PG. 75 "B"
BLK BK. T-32-2-16
(THIS IS A PORTION OF 16)
CHICK SPRINGS TOWNSHIP
TAYLORS, S. C.
GREENVILLE CO.

I CERTIFY THE ABOVE LOT HAS
BEEN SURVEYED AND IS AS SHOWN
TO THE BEST OF MY KNOWLEDGE.

Kenneth P. Gould
S. C. REG. NO 4035

Seal 	PROPERTY		Drawn By K.T.G. JR.
	OF		Checked By
	SYBIL M. STEWART		Scale 1" = 30'
	GOULD & ASSOC		Date 10/29/80
	SURVEYORS		File No.
TAYLORS, S.C. 29084-90		Dwg. No.	103 3.0001