


PLAT OF CORRECTION -
THIS PLAT MADE TO
CORRECT AVERAGE, SEE
PLAT AT 5N-71
RAC OFFICE
DATED 10-7-75

FILED
GREENVILLE CO. S.C.
DEC 2 10 16 AM '80
DONNIE S. TANKERSLEY
R.M.C.

MICROFILMED

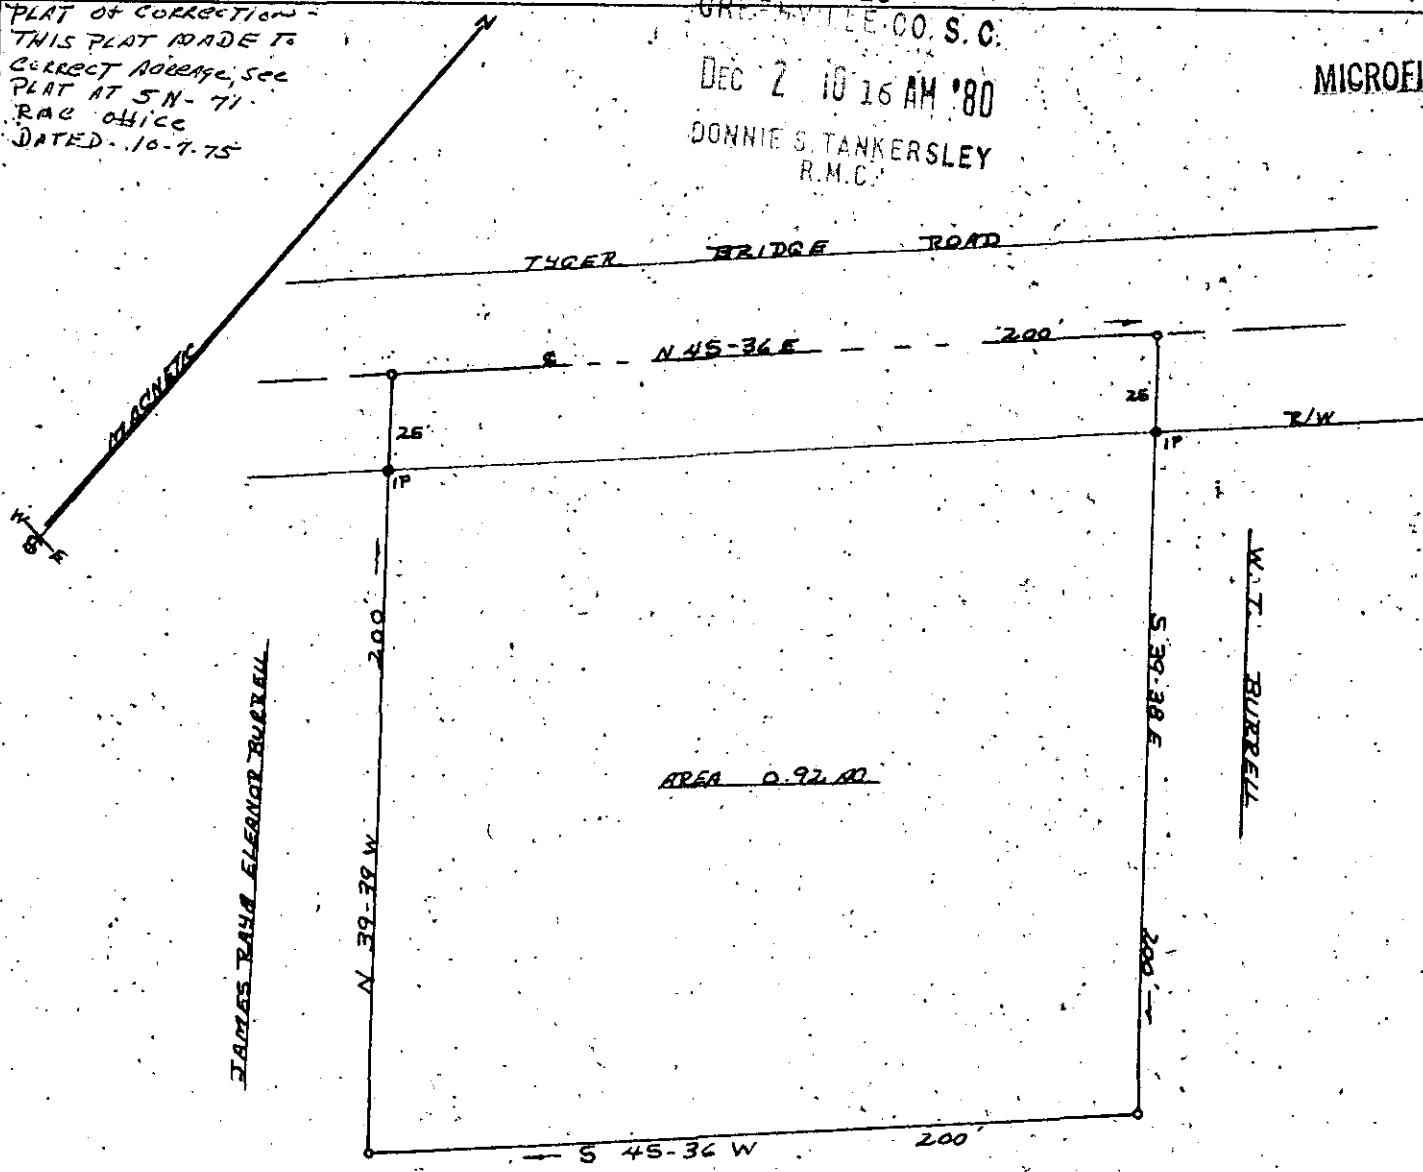

600
1 DE 2 80


DEC 2 1980

PLAT OF PROPERTY

OF

W.T. & ELOA BURRELL

ONEAL TOWNSHIP, GREENVILLE CO.
STATE OF SOUTH CAROLINA
SCALE 1" = 50' 12-29-79

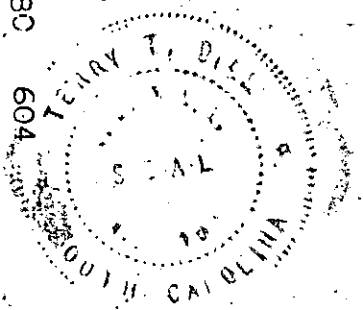

Terry T. Dill
REG. CEE L5, No. 104
P.O. 2, TAYLORS, S.C.

8-J-19

16699