

This is to certify that on Nov. 26, 1980, I surveyed the property shown on this plat, known as Lot 6A & Pt. Lot 6 on plat of Alta Vista, recorded in the RMC Office of Greenville County in Plat Book G on page 20, and that the property lines, walls and buildings are as shown hereon; that the building located on said lot does not encroach or project on adjacent streets or property, and that no adjacent walls or buildings encroach or project on said PT. LOT 6 premises, and that no utility lines cross this property except as shown hereon. This property is not located in a designated flood hazard area.

James R. Freeland
 James R. Freeland RLS & PE 4781

FILED
 GREENVILLE CO. S.C.
 DEC 2 3 58 PM '80
 DONNIE S. TANKERSLEY
 R.M.C.

16696

DEC 2 1980


8-9-22

GCTO -----3 DE•2 80

STATE OF SOUTH CAROLINA
GREENVILLE COUNTY

FREELAND & ASSOCIATES
 Engineers • Land Surveyors

GREENVILLE, S.C.

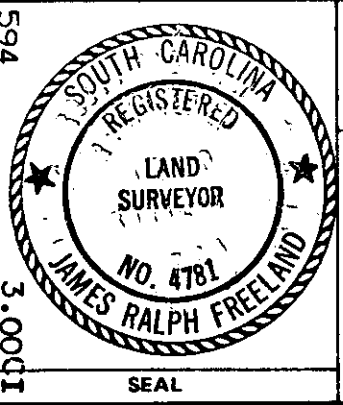

ALTA - VISTA
LOT 6A & PT. LOT 6
PROPERTY OF
STEPHEN F. HEINER
KELSEY B. HEINER

SURVEY D.C.H.
DRAWN B.R.
CHECK <i>MC</i>
SCALE 1" = 40'
DATE NOV. 26, 1980
DWG. NO. 5676