


FILED  
GREENVILLE CO. S.C.  
DEC 12 10 00 AM '80  
DONNIE S. TANKERSLEY  
R.M.C.

-6-

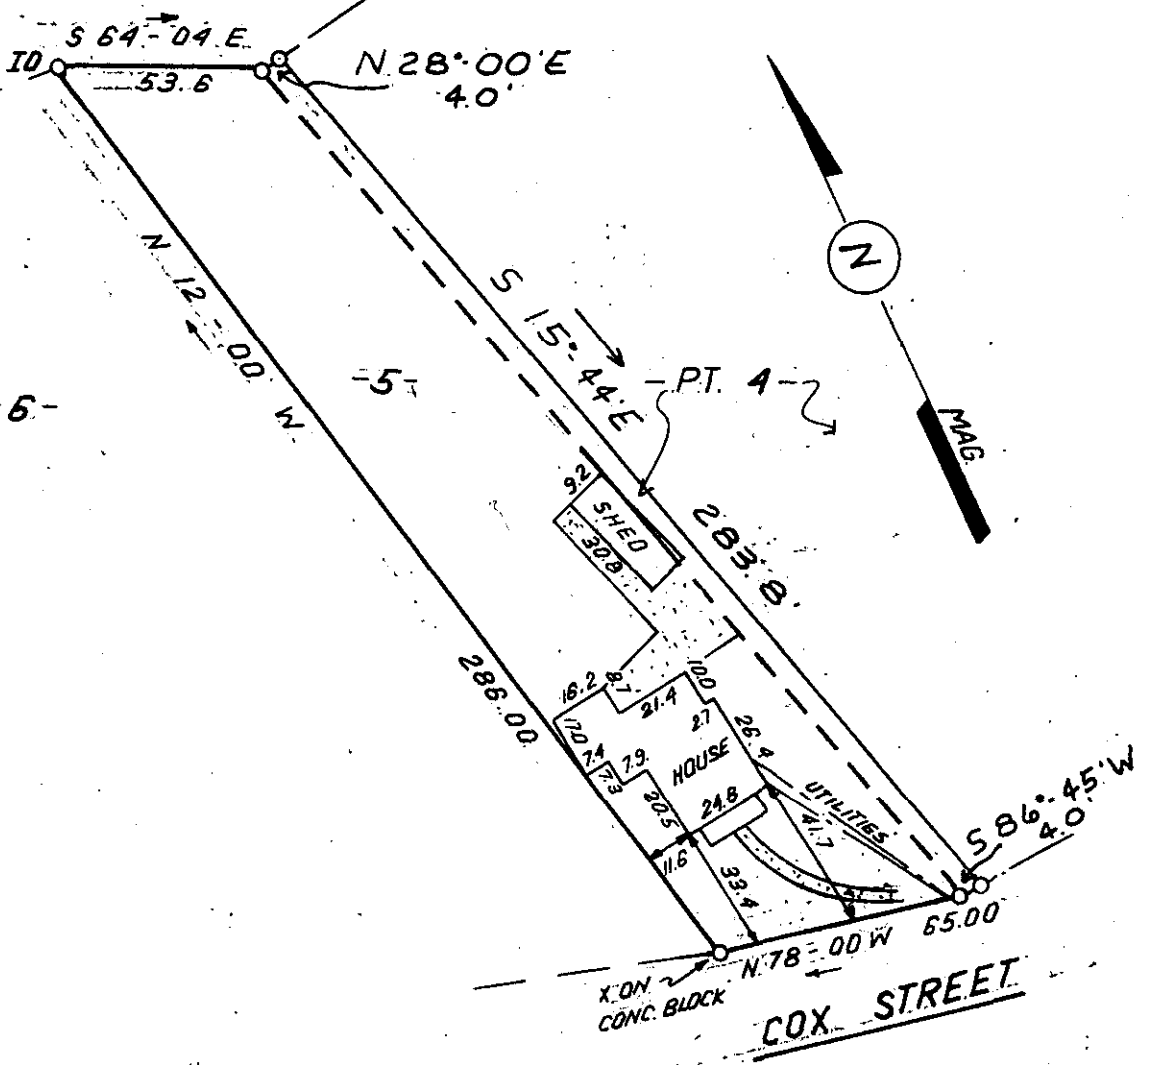

DEC 12 1980

8-8-40 17782

REVISED 12-3-80

TAX BLOCK BOOK 314-3-42



SEAL

STATE OF SOUTH CAROLINA  
GREENVILLE COUNTY

PROPERTY OF  
WILLIAM PEARSON  
MARY PEARSON

FREELAND & ASSOCIATES  
Engineers • Land Surveyors

GREENVILLE, S.C.

SURVEY L.T.

DRAWN B.P.

CHECK M.C.

SCALE 1" = 50'

DATE AUG. 18. 80.

DWG. NO. 5434