

Note: Improvements on this lot are not in a flood hazard area.

SILVER CREEK ROAD
WATER IN ST. R/W.

FILED
GREENVILLE CO. S. C.
DEC 15 3 08 PM '80
DONNIE S. TANKERSLEY
R.M.C.

PROPERTY OF
WILLIAM E. LEYERS & BEVERLY F. LEYERS
NEAR GREENVILLE, S. C.
SCALE 1" = 40' 2 DEC. 1980

This is to certify that on the 2nd day of December, 1980, I surveyed the property shown on this plat, being known as lot 254 on plat of REVISED PLAT - LOTS 253 & 254 and recorded in the RMC Office Greenville County, S. C., in Plat Book "5 - Q" at Page 108; and that the property lines, walls and buildings are as shown hereon, and that the walls and buildings located on said lot do not encroach or project on adjacent street or property, and that no adjacent walls or buildings encroach or project on said premises, and no power lines cross this property except as shown hereon.

DEC 15 1980


8-J-50

17915

R. B. Bruco

R. B. Bruco, RLS #1952

CAROLINA SURVEYING CO.
112 Manly St.
Greenville, S. C.

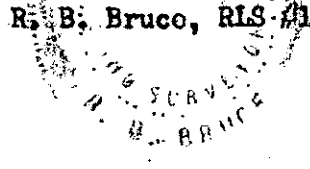

3.0001