


8 K. 25 ✓

22351

This is to certify that on January 27, 1981, I surveyed the property shown on this plat, known as Tract 3 on plat of R. T. Stone Estate, recorded in the RMC Office of Greenville County in Plat Book 000 on page 6, and that the property lines, walls and buildings are as shown hereon; that the building located on said lot does not encroach or project on adjacent streets or property, and that no adjacent walls or buildings encroach or project on said premises, and that no utility lines cross this property except as shown hereon. This property is not located in a designated flood hazard area.

*James R. Freeland*  
James R. Freeland RLS & PE 4781

*Freeland & Associates*

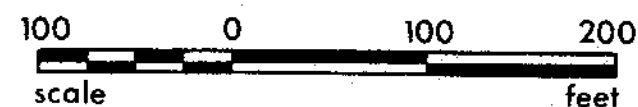

**STATE OF SOUTH CAROLINA**  
**GREENVILLE COUNTY**

R.T. STONE ESTATE  
TRACT 3  
PROPERTY OF  
THERON E. BARNETT

FREELAND & ASSOCIATES  
Engineers • Land Surveyors  
GREENVILLE, S.C.

SURVEY D.C.H.  
DRAWN B.R.  
CHECK M.C.  
SCALE 1" = 100'  
DATE JAN. 27, 1981  
DWG. NO. 6129

MICROFILMED