


MICROFILMED


Note:
Improvements on this
lot are not in a
flood hazard area.

FILED
GREENVILLE CO. S. C.
FEB 25 9 09 AM '81
DONNE S. TANKERSLEY
M.C.

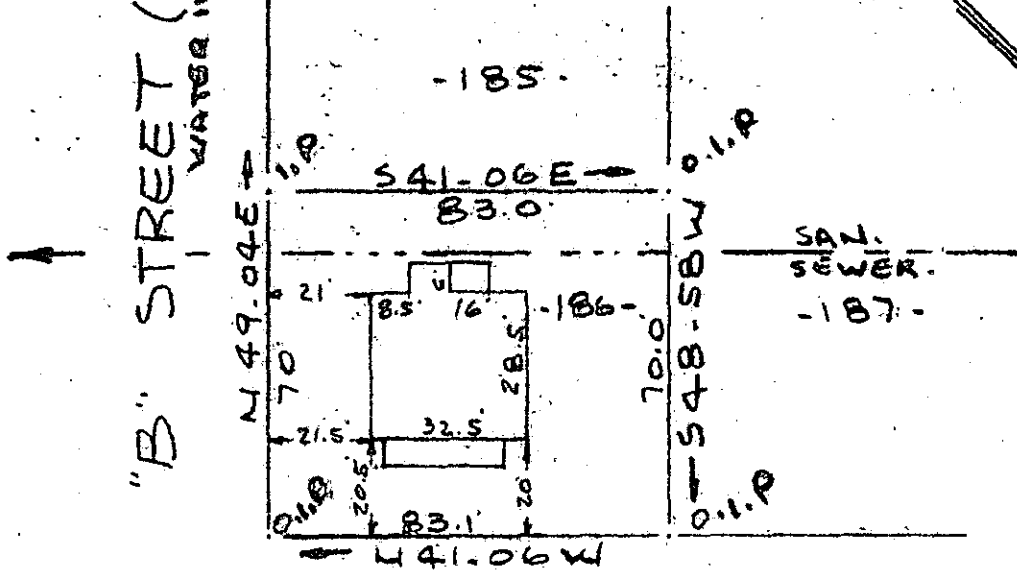

FIFTH AVENUE (50')
WATER IN ST. 91 W.

PROPERTY OF
DONALD M. INABINETT
NEAR GREENVILLE GREENVILLE CO, S.C.
SCALE 1" = 40' 20 FEB 1981

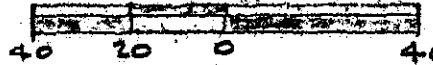

This is to certify that on the 20th day of February, 1981, I surveyed the property shown on this plat, being known as lot 186 on plat of F. W. POE MFG. CO. and recorded in the REC Office Greenville County, S. C., in Plat Book " Y " at Pages 28 & 29; and that the property lines, walls and buildings located on said lot do not encroach or project on adjacent street or property, and that no adjacent walls or buildings encroach or project on said premises, and no power lines cross this property except as shown hereon.

✓ J-L-77

FEB 25 1981

R. B. Bruce
R. B. Bruce, REC #1952

23970



CAROLINA SURVEYING CO.
112 Manly St.
Greenville, S. C.

[Handwritten signature]

3070 --- 1 FEB 25 81 1003

3.0001