


FILED  
GREENVILLE CO. S. C.

FEB 27 4 18 PM '81

DONNIE S. TANKERSLEY  
R.M.C.

MICROFILMED

MAG.

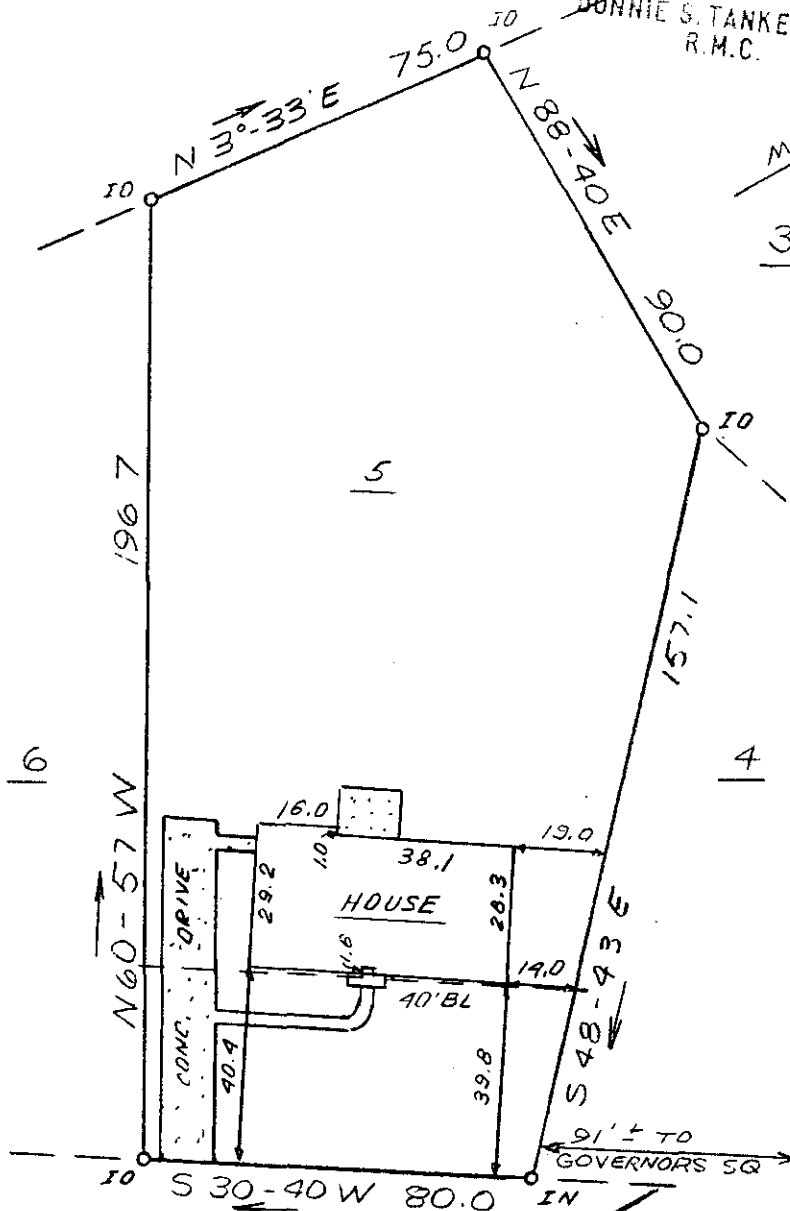

3 This is to certify that on February 25, 1981, I surveyed the property shown on this plat, known as Lot 5 on plat of Governors Square, recorded in the RMC Office of Greenville County in Plat Book 5P on page 8, and that the property lines, walls and buildings are as shown hereon; that the building located on said lot does not encroach or project on adjacent streets or property, and that no adjacent walls or buildings encroach or project on said premises, and that no utility lines cross this property except as shown hereon. This property is not located in a designated flood hazard area.

4 5' drainage and utility easement each side of all side and rear lot lines.

GOVERNORS CT. 24340

*James R. Freeland*  
James R. Freeland RLS & PE 4781

82-88

FEB 27 1981

540.3-1-29

PRINT MACHINE INC.



SEAL

STATE OF SOUTH CAROLINA  
GREENVILLE COUNTY

GOVERNORS SQUARE  
LOT 5  
PROPERTY OF  
YVONNE D. KING  
SUSAN KING

FREELAND & ASSOCIATES  
Engineers • Land Surveyors

GREENVILLE, S.C.

SURVEY L.T.

DRAWN K.S.

CHECK *ML*

SCALE 1" = 40'

DATE FEB 25.81

DWG. NO. 6200